



Purchase College

STATE UNIVERSITY OF NEW YORK

735 Anderson Hill Road
Purchase, NY 10577-1402
www.purchase.edu

Procurement Department
IFB – PAC Entrance Lobby Railings
Project SU-061022
Addendum #1

To: Prospective Bidders

No. of Pages: 3 pages

SUNY Purchase hereby issues this Addendum, dated 8/12/2022, for the above referenced IFB, in order to provide the following clarifications:

Item 1:

SUNY Purchase received a request for information via email during the procurement’s Question & Answer period. The drawing, which was the subject of the request, is provided on page 3.

Please be sure to sign THIS ADDENDUM (as acknowledgment that your firm received it) and submit it with your bid package.

Respectfully,

Sheli Taylor
Associate Director of Contract & Procurement Services

Acknowledgement of ADDENDUM #1

Signature Date

Typed printed name and title


Company name

Purchase College Project #SU-061022
PAC ENTRANCE LOBBY RAILING


Addendum #01 - Bidder's Questions & Answers

Q1. The specification in drawing sheet A-001 dated January 19, 2022, refer to 1974 shop drawings to be provided by SUNY. Please provide shop drawing.


A1. Please see attached shop drawing for reference.

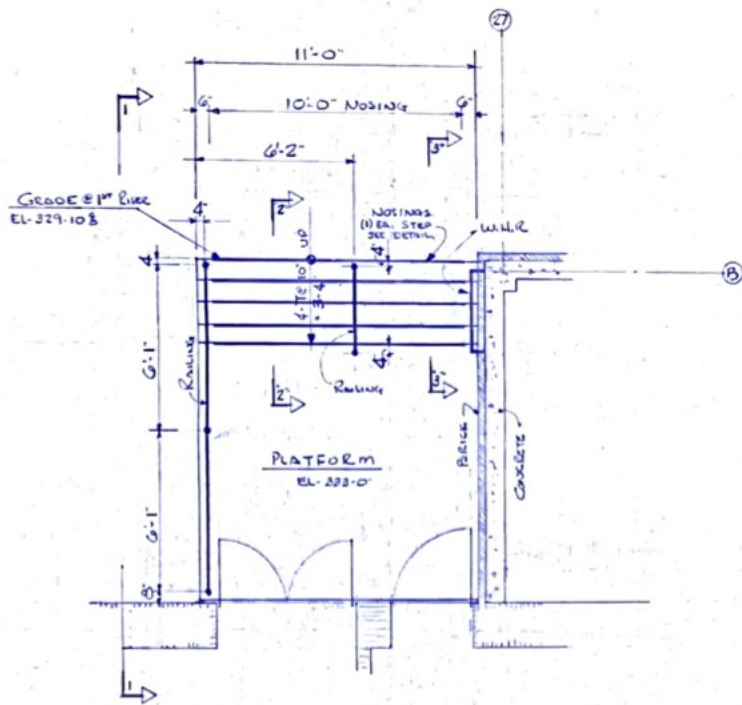


PLAN OF RAILING
@ CONC. STAIR # L-4
(LOWER LOBBY LEVEL)

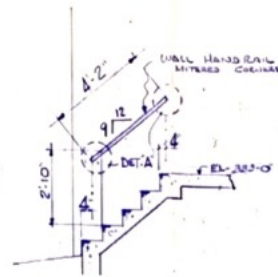


SECTION '3-3'

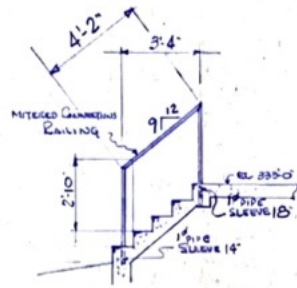


SECTION '2-2'

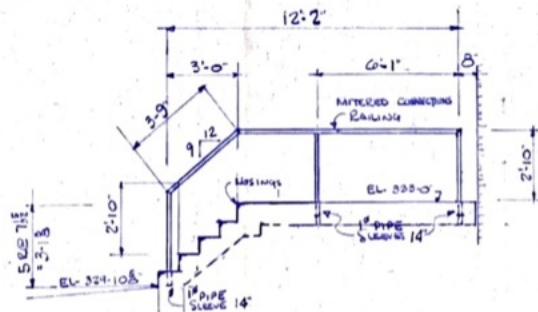

SECTION '1-1'

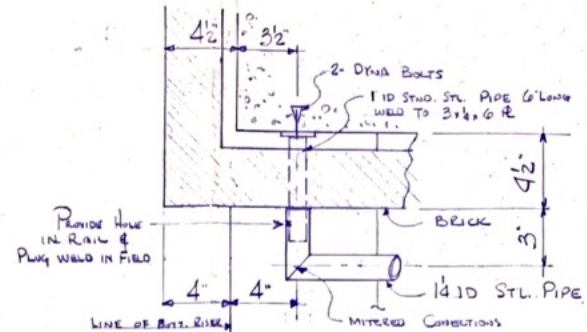

DETAIL 'A' (WALL RAIL)

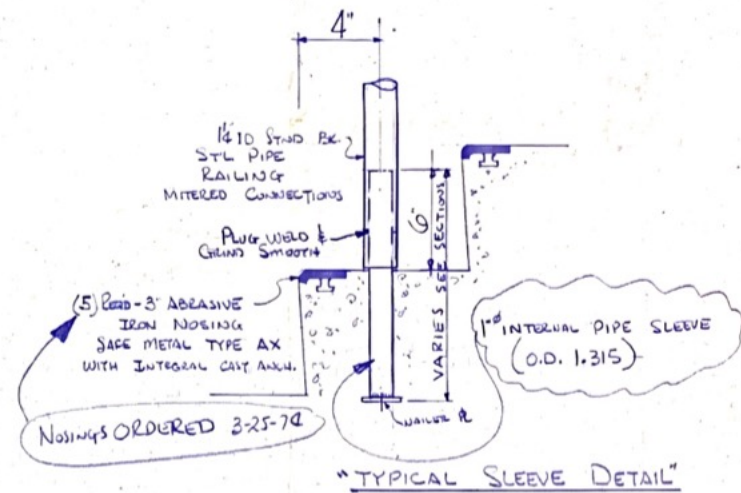

"TYPICAL SLEEVE DETAIL"

SLEEVES - FURNISH ONLY
NOSINGS - FURNISH ONLY
RAILING - FURNISH & ERECT
PAINT "ONE SHOP COST"

RECEIVED
AUG 23 1974
UNITED IRON INC.

REFER TO ARCH. DRAW. U-202, U-200

APP'D		94-061-5100	UNITED IRON, INC.	212-278-5275
		6 REVIEW PLACE	MOUNT VERNON, N. Y.	
		OR PERFORMING ARTS	STATE UNIV.	DATE BY
		SVCS	NY	ED
		ARCH. EDWARD L. BAUMANN		CHKD BY
		SC. POLELA ELDON CORP.		
		TITLE RAILING & NOSINGS		JOB NO.
		& CONC. STAIR # L-4		374
				DWG NO.
				LM 2

NOTE: ALL DIMENSIONS SHOWN ARE AS SHOWN UNLESS OTHERWISE NOTED.

"LOBBY & CENTRAL AREA"

FIELD COPY

7-9-74 APPL.
3-15-73 APPL.