

REV.	DATE	ITEM

**NOTICE**  
 THESE DRAWINGS ARE BASED ON CONSTRUCTION DRAWINGS NOT PREPARED BY BBS ARCHITECTS, LANDSCAPE ARCHITECTS AND ENGINEERS, P.C. AND THEREFORE MAY NOT REPRESENT THE CONDITIONS AS CONSTRUCTED AT THE TIME. ALL EXISTING CONDITIONS SHOWN ARE REPRESENTED AS SUGGESTIVE INFORMATION AS THEY MAY NOT HAVE BEEN BUILT AND SET (FIELD) PER THE ORIGINAL DOCUMENTS OR PER THE OWNER'S INFORMATION.



**KEY PLAN**  
 NOT TO SCALE

**PROJECT**  
 MULTI-PURPOSE SYNTHETIC TURF FACILITY  
 PURCHASE COLLEGE  
 STATE UNIVERSITY OF NEW YORK  
 735 ANDERSON HILL ROAD, PURCHASE, NEW YORK 10577

**DWG TITLE**  
 RECORD DRAWING - SUBDRAINAGE DETAILS

**DRAWING BY:** JRL  
**CHECK BY:** JRL

**NOTICE**  
 THIS DRAWING PREPARED FOR THE SPECIFIC PROJECT INDICATED IS AN INSTRUMENT OF SERVICE AND THE PROPERTY OF BBS ARCHITECTS, LANDSCAPE ARCHITECTS AND ENGINEERS, P.C. WITHOUT THE WRITTEN CONSENT OF BBS ARCHITECTS, LANDSCAPE ARCHITECTS AND ENGINEERS, P.C. NO PART OF THIS DRAWING OR ANY OTHER PROJECT IS PROHIBITED, ANY ALTERATION OR REPRODUCTION OF THIS DOCUMENT IS ALSO PROHIBITED WITHOUT THE WRITTEN CONSENT OF THE ARCHITECT OR ENGINEER.

**BBS**  
 ARCHITECTS  
 LANDSCAPE ARCHITECTS  
 ENGINEERS  
 244 EAST MAIN STREET, PATCHOGUE, NEW YORK 11772  
 187 WOLF ROAD, STE. 205 ALBANY, NEW YORK 12205  
 T. 631.475.0349 F. 518.621.7650  
 F. 631.475.0351

**BBS ASSUMES NO RESPONSIBILITY TO THE ACCURACY OF THE INFORMATION SHOWN ON THIS DRAWING - IT IS PROVIDED FOR INFORMATIONAL PURPOSES ONLY**


**CONTRACT No.** SU-092823 - GENERAL CONST.  
 SU-092823 - ELECTRICAL

**CLIENT** SUNY PURCHASE COLLEGE


**PROJECT** MULTI-PURPOSE SYNTHETIC TURF FACILITY

**DWG TITLE** RECORD DRAWING SUBDRAINAGE DETAILS


**SCALE:** AS NOTED  
**DATE:** OCTOBER 25, 2023  
**BID PICK-UP:**  
**FILE No.:** 23-158

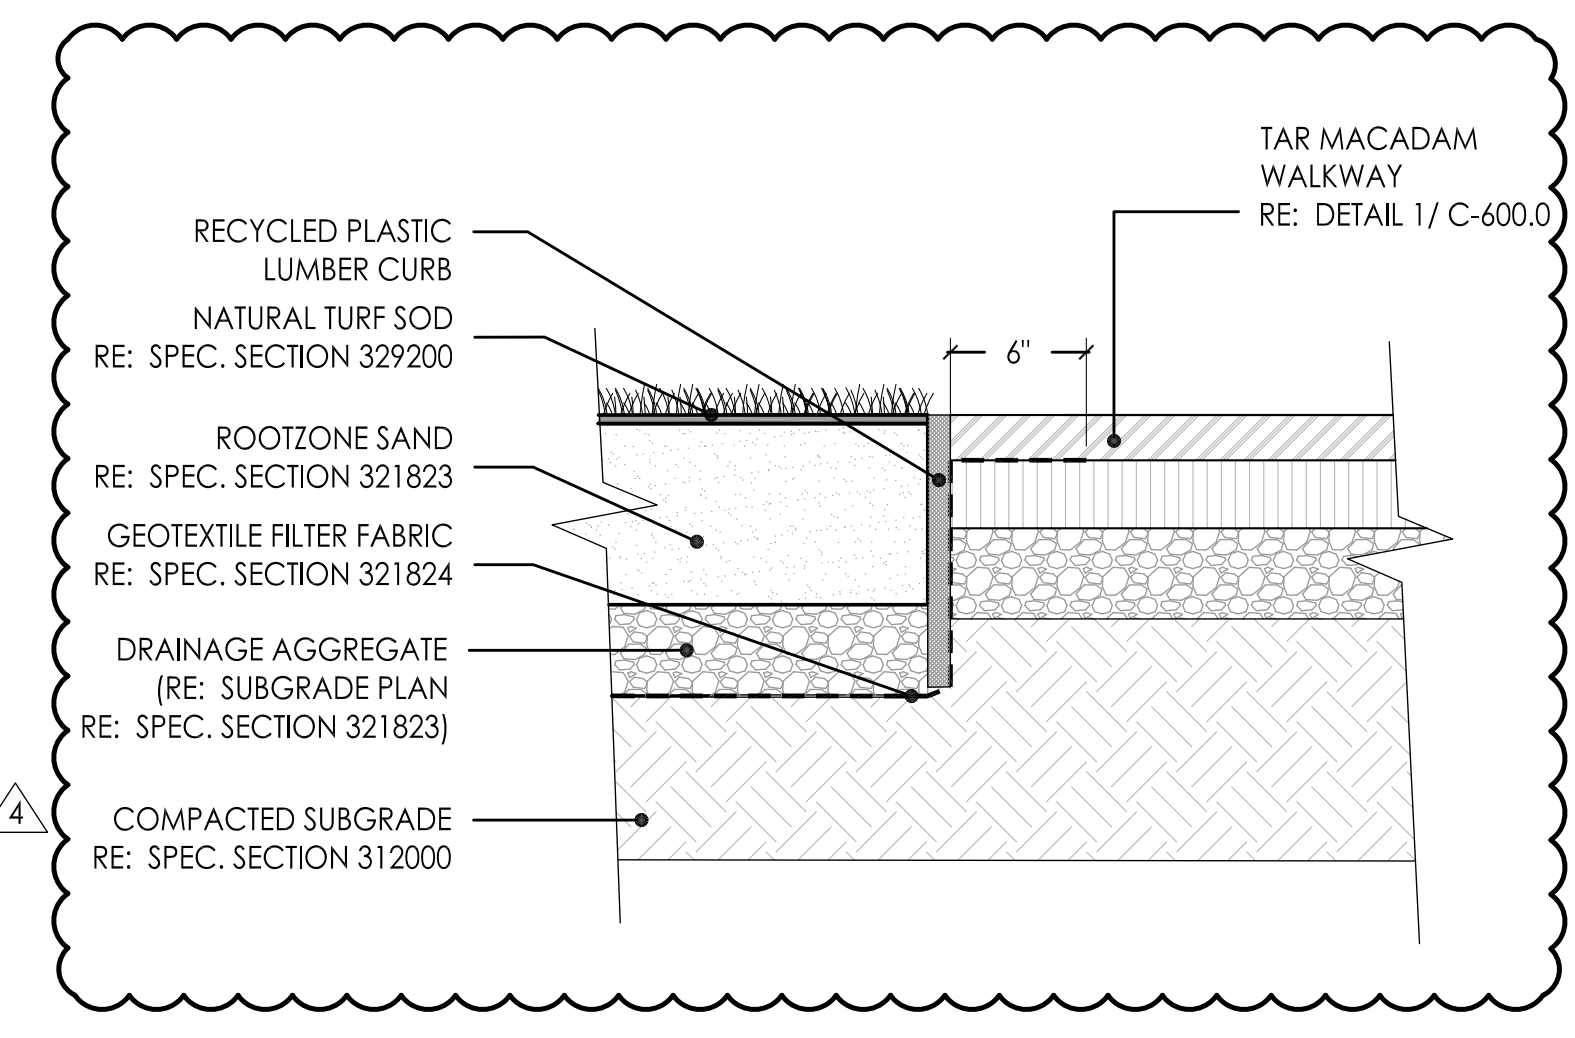


**2 NATURAL TURF EDGE AT ASPHALT WALKWAY**  
 SCALE: 1 1/2" = 1'-0"

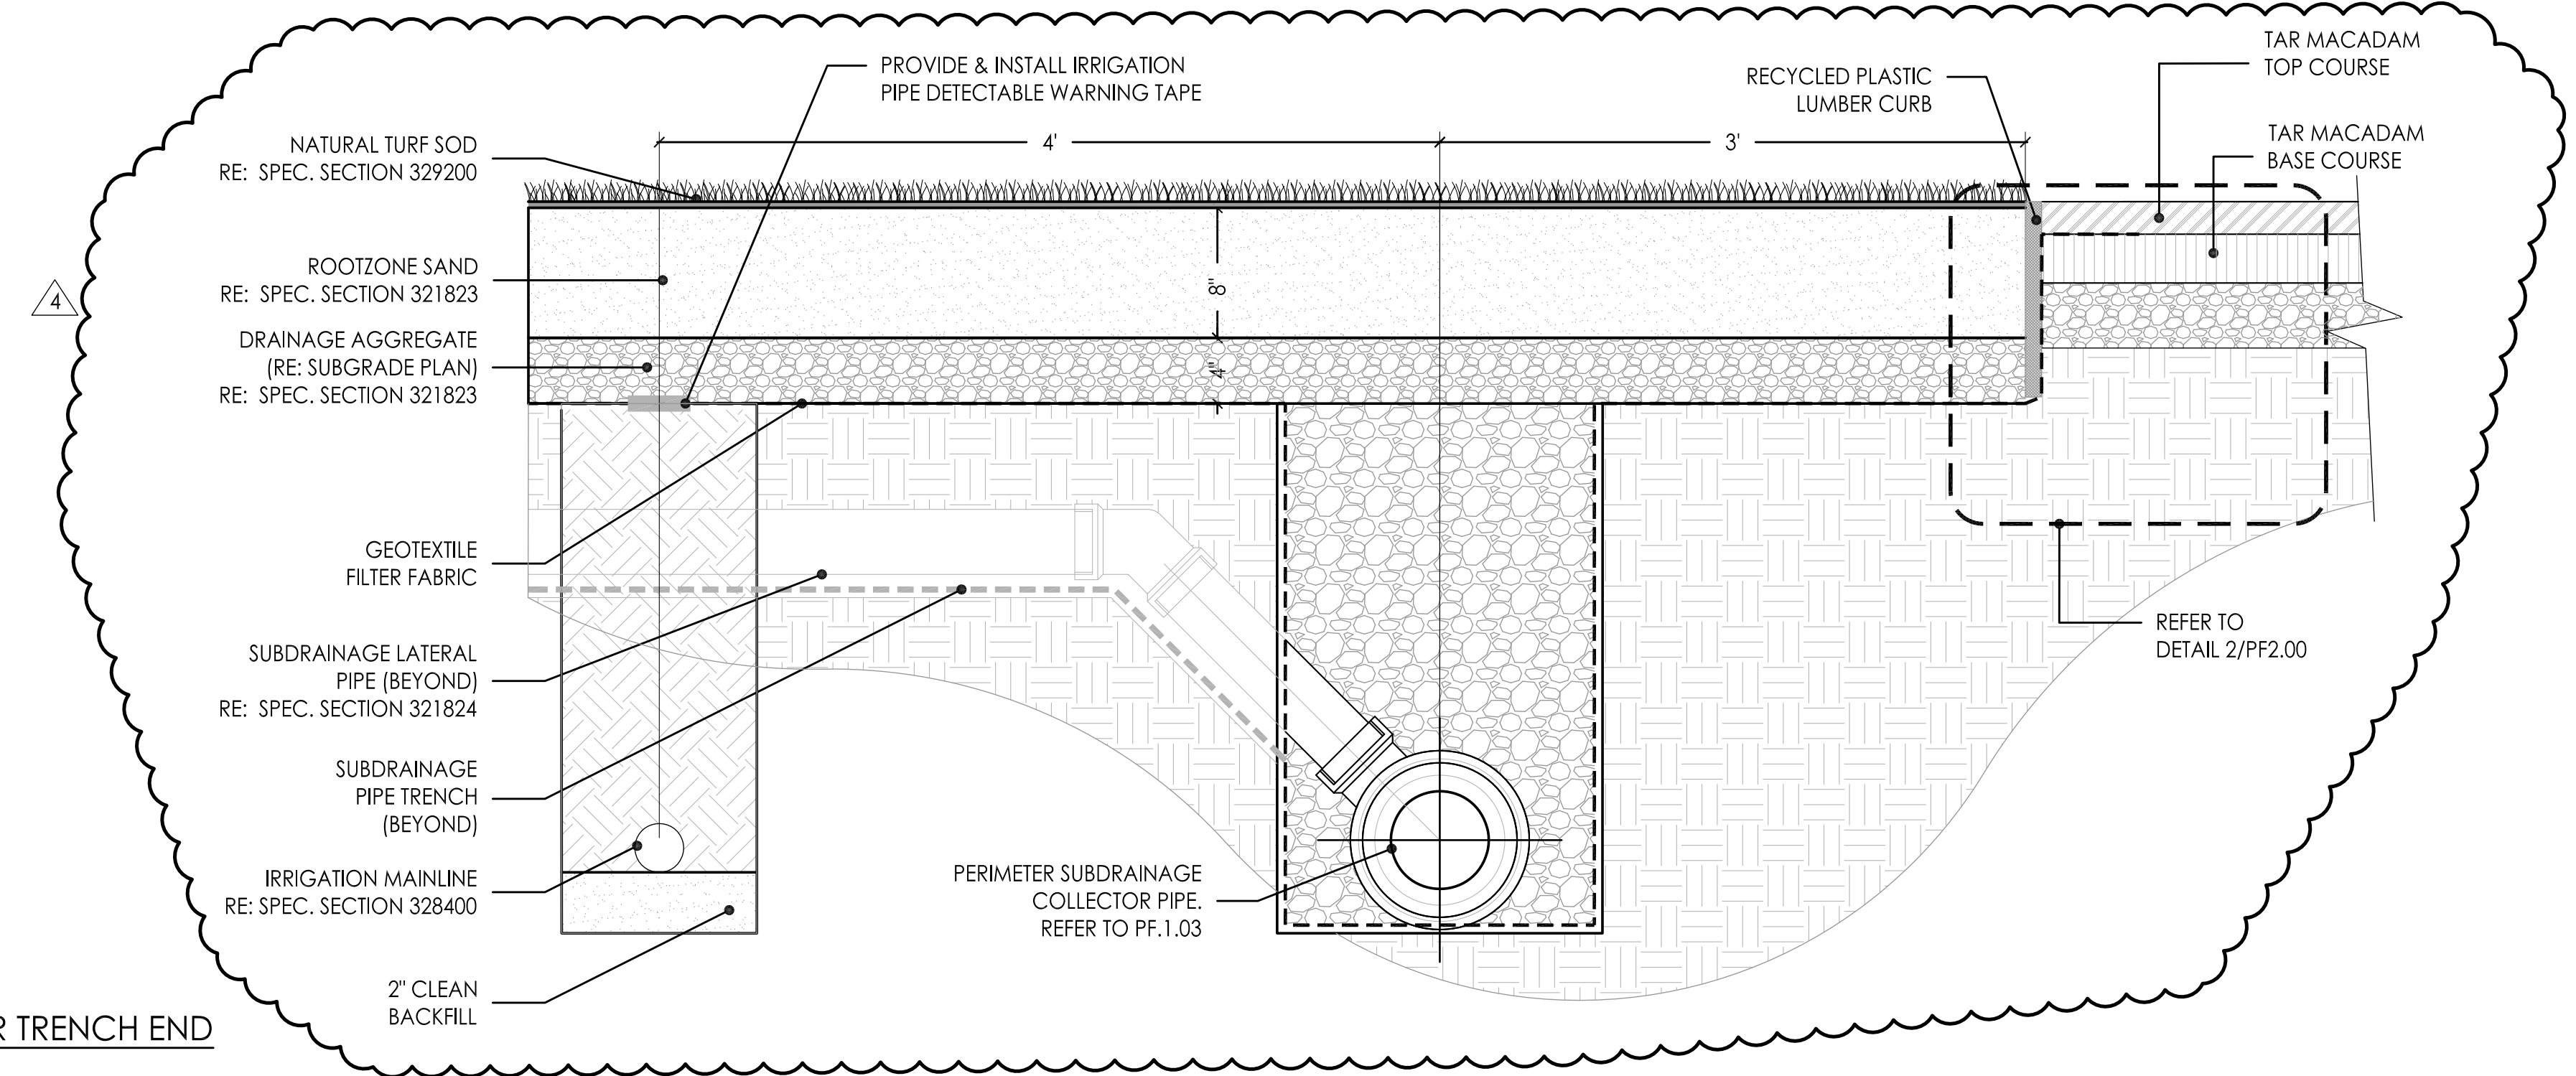


**1 TYPICAL RUN-OFF & ADJACENT PROFILE AT HEADER TRENCH END**  
 SCALE: 1 1/2" = 1'-0"

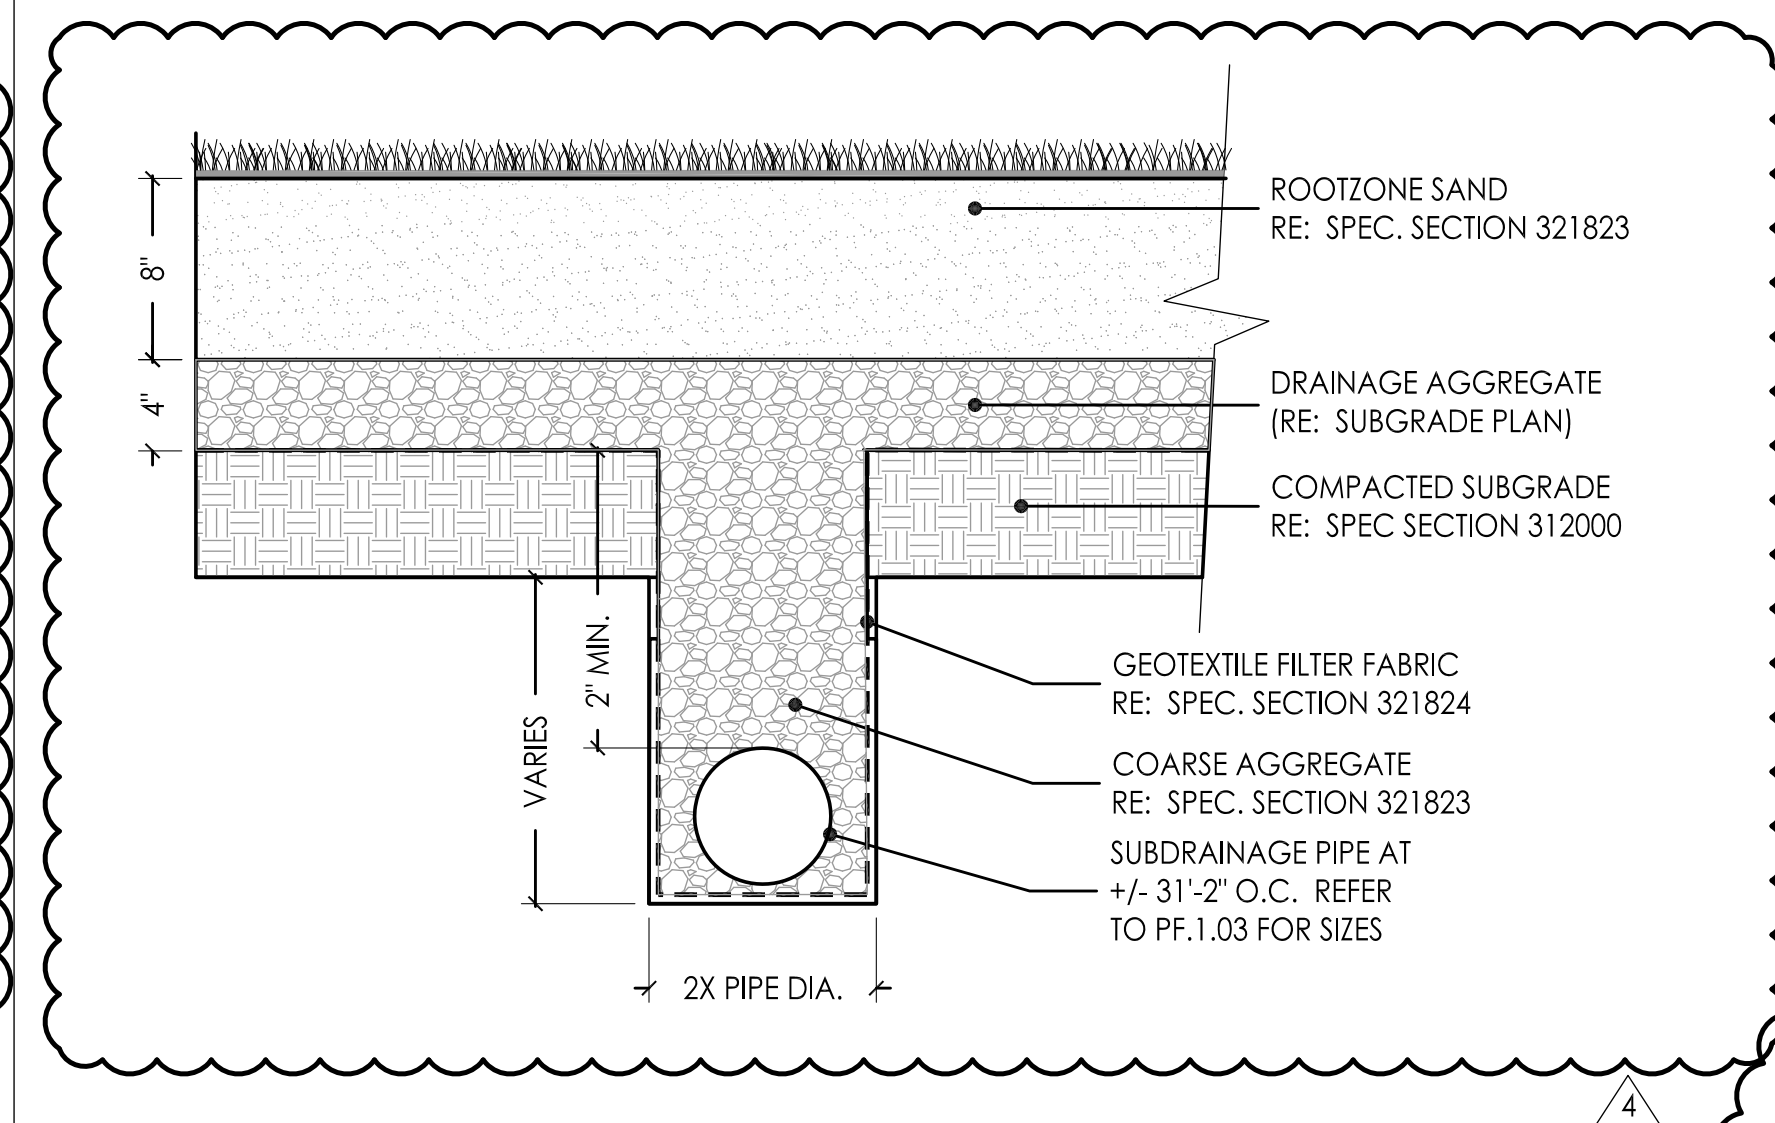


**4 LATERAL TRENCHING PIPE**  
 SCALE: 1 1/2" = 1'-0"

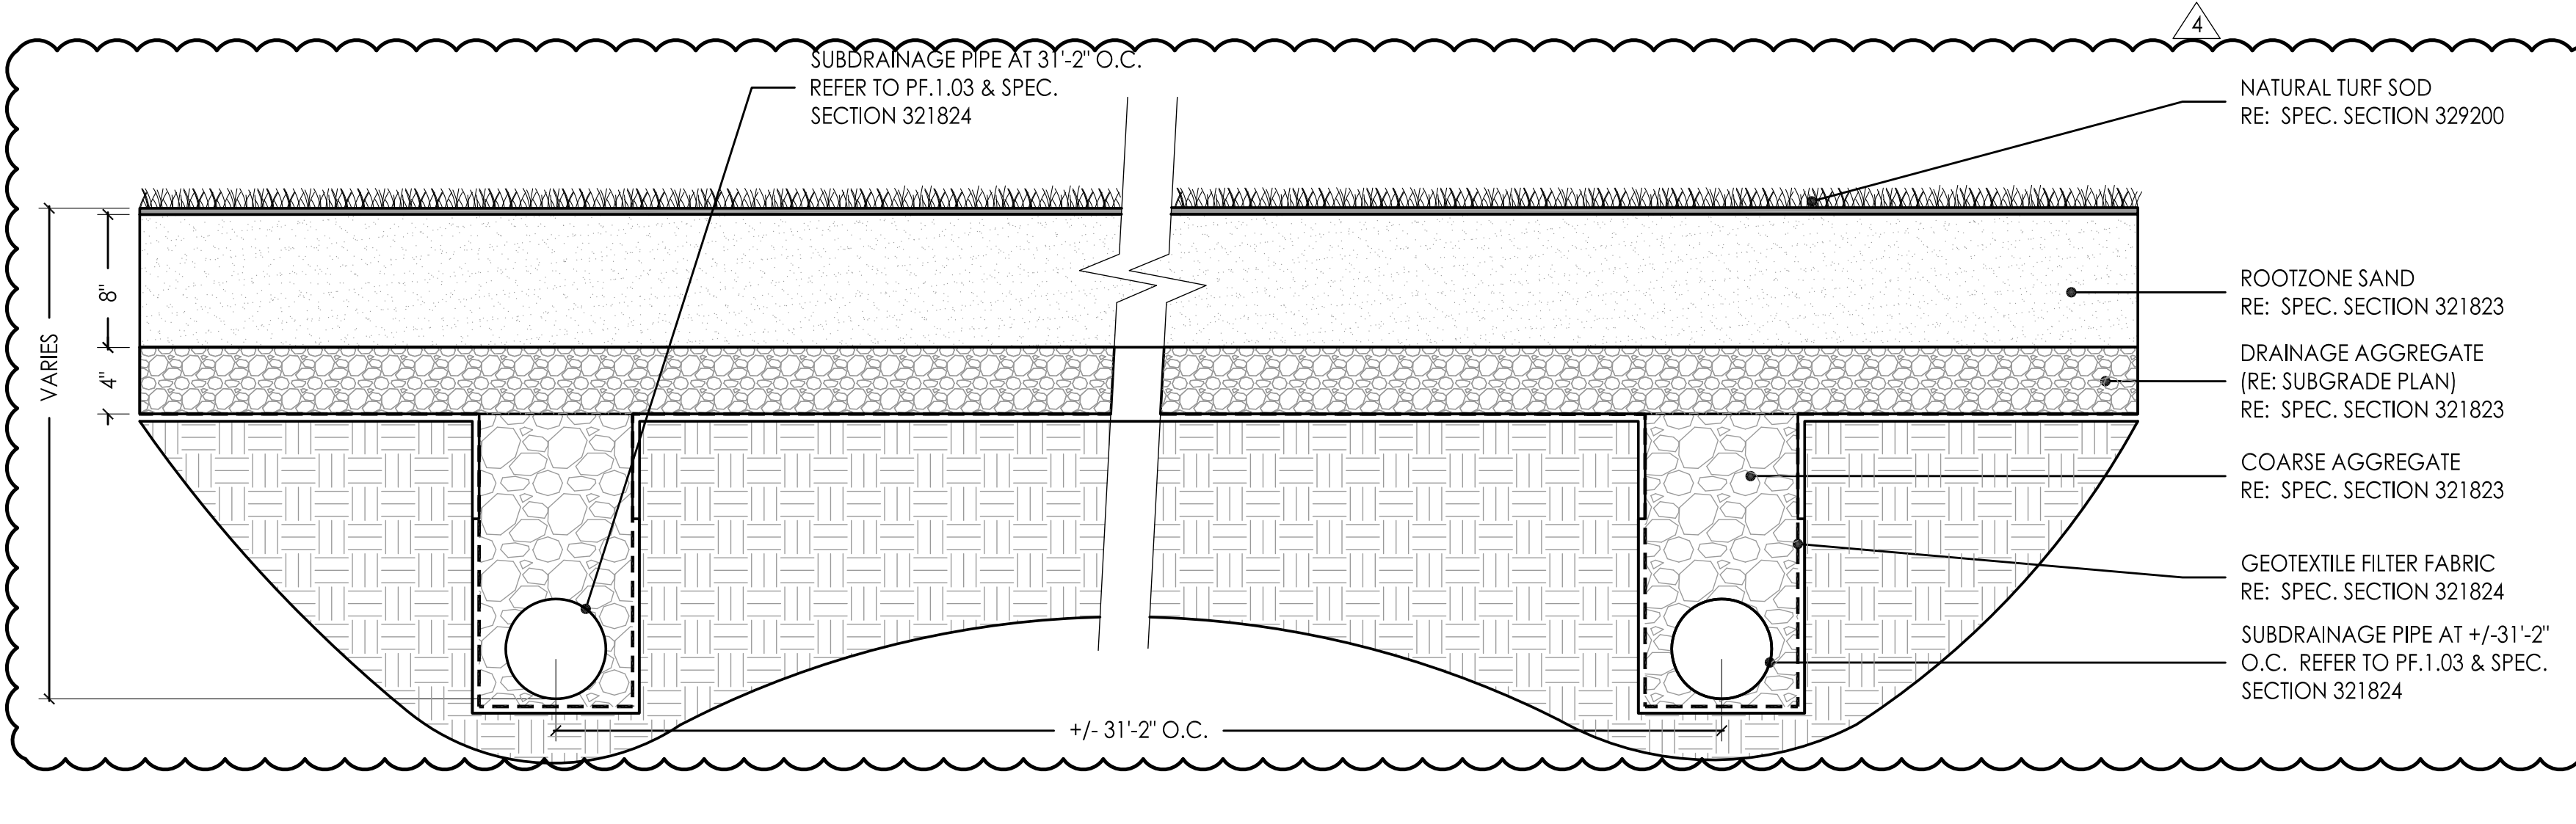


**3 NATURAL GRASS PITCH PROFILE**  
 SCALE: 1 1/2" = 1'-0"

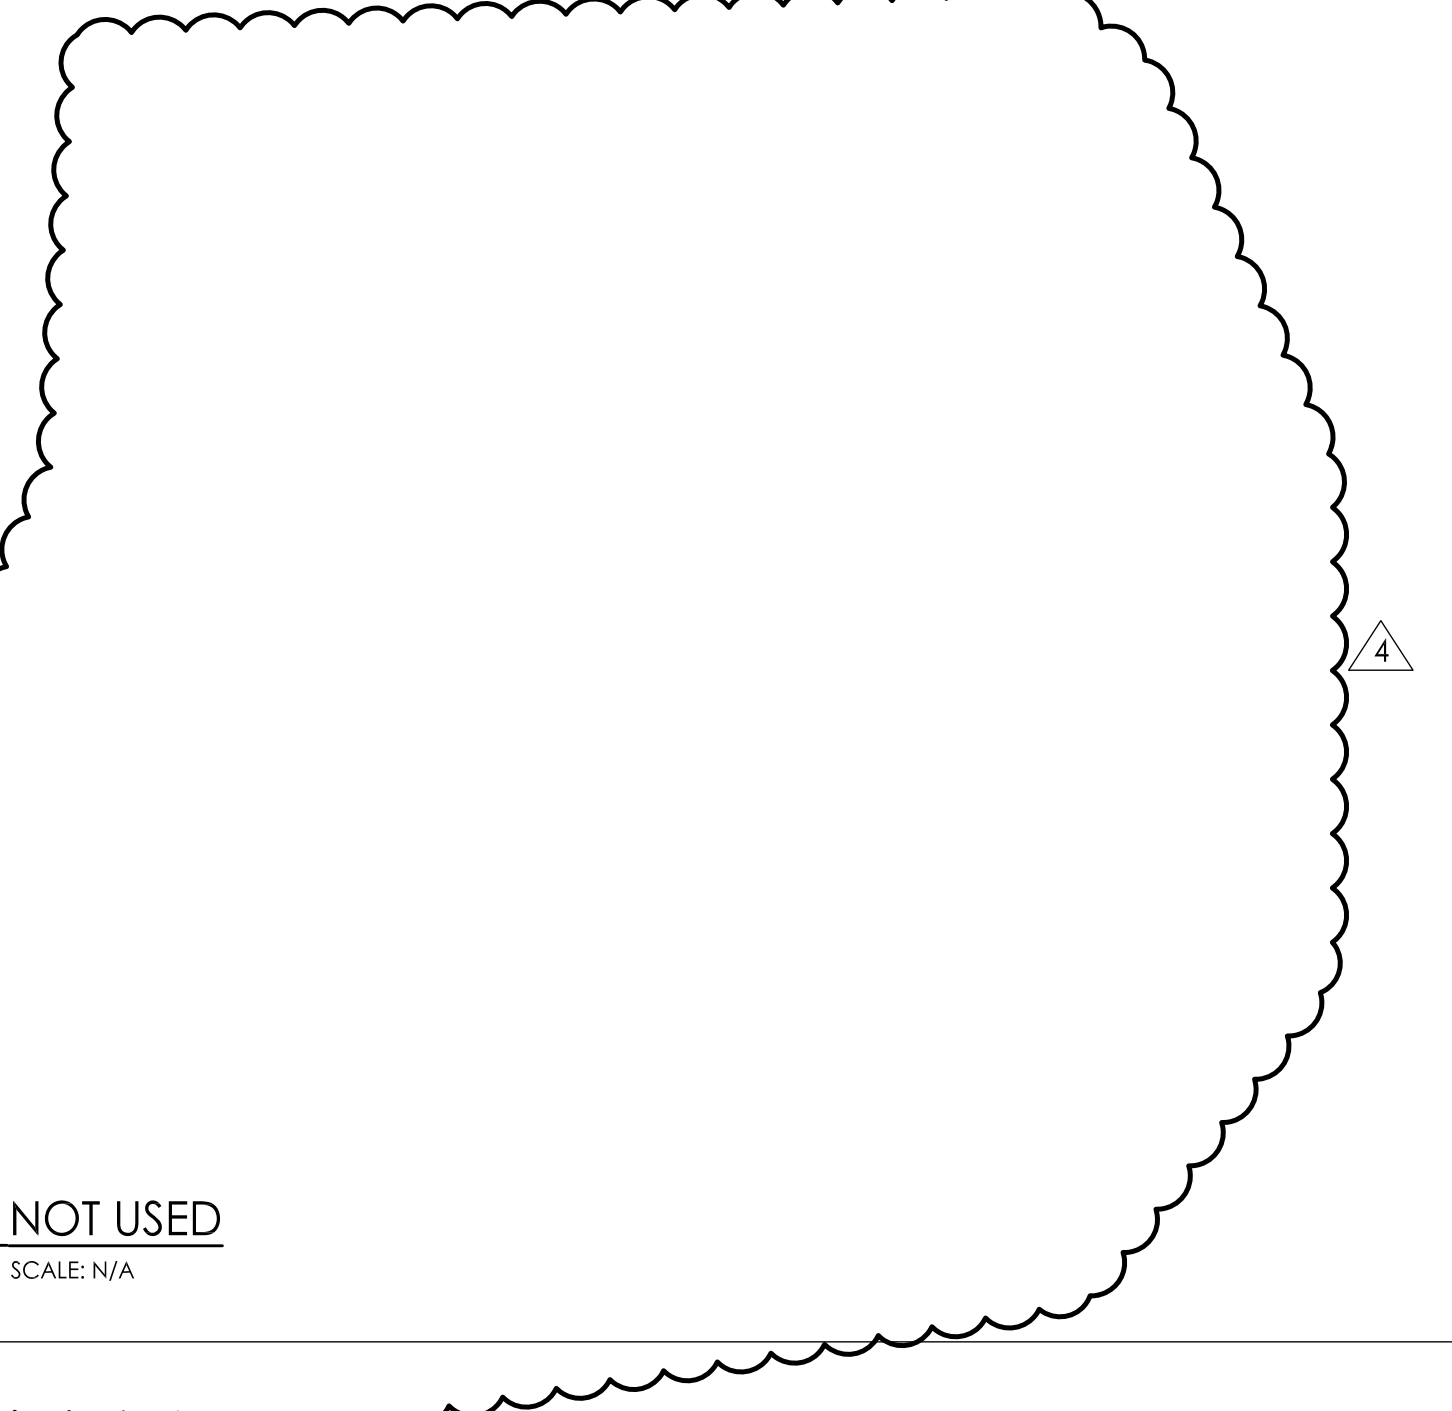


**5 NOT USED**  
 SCALE: N/A

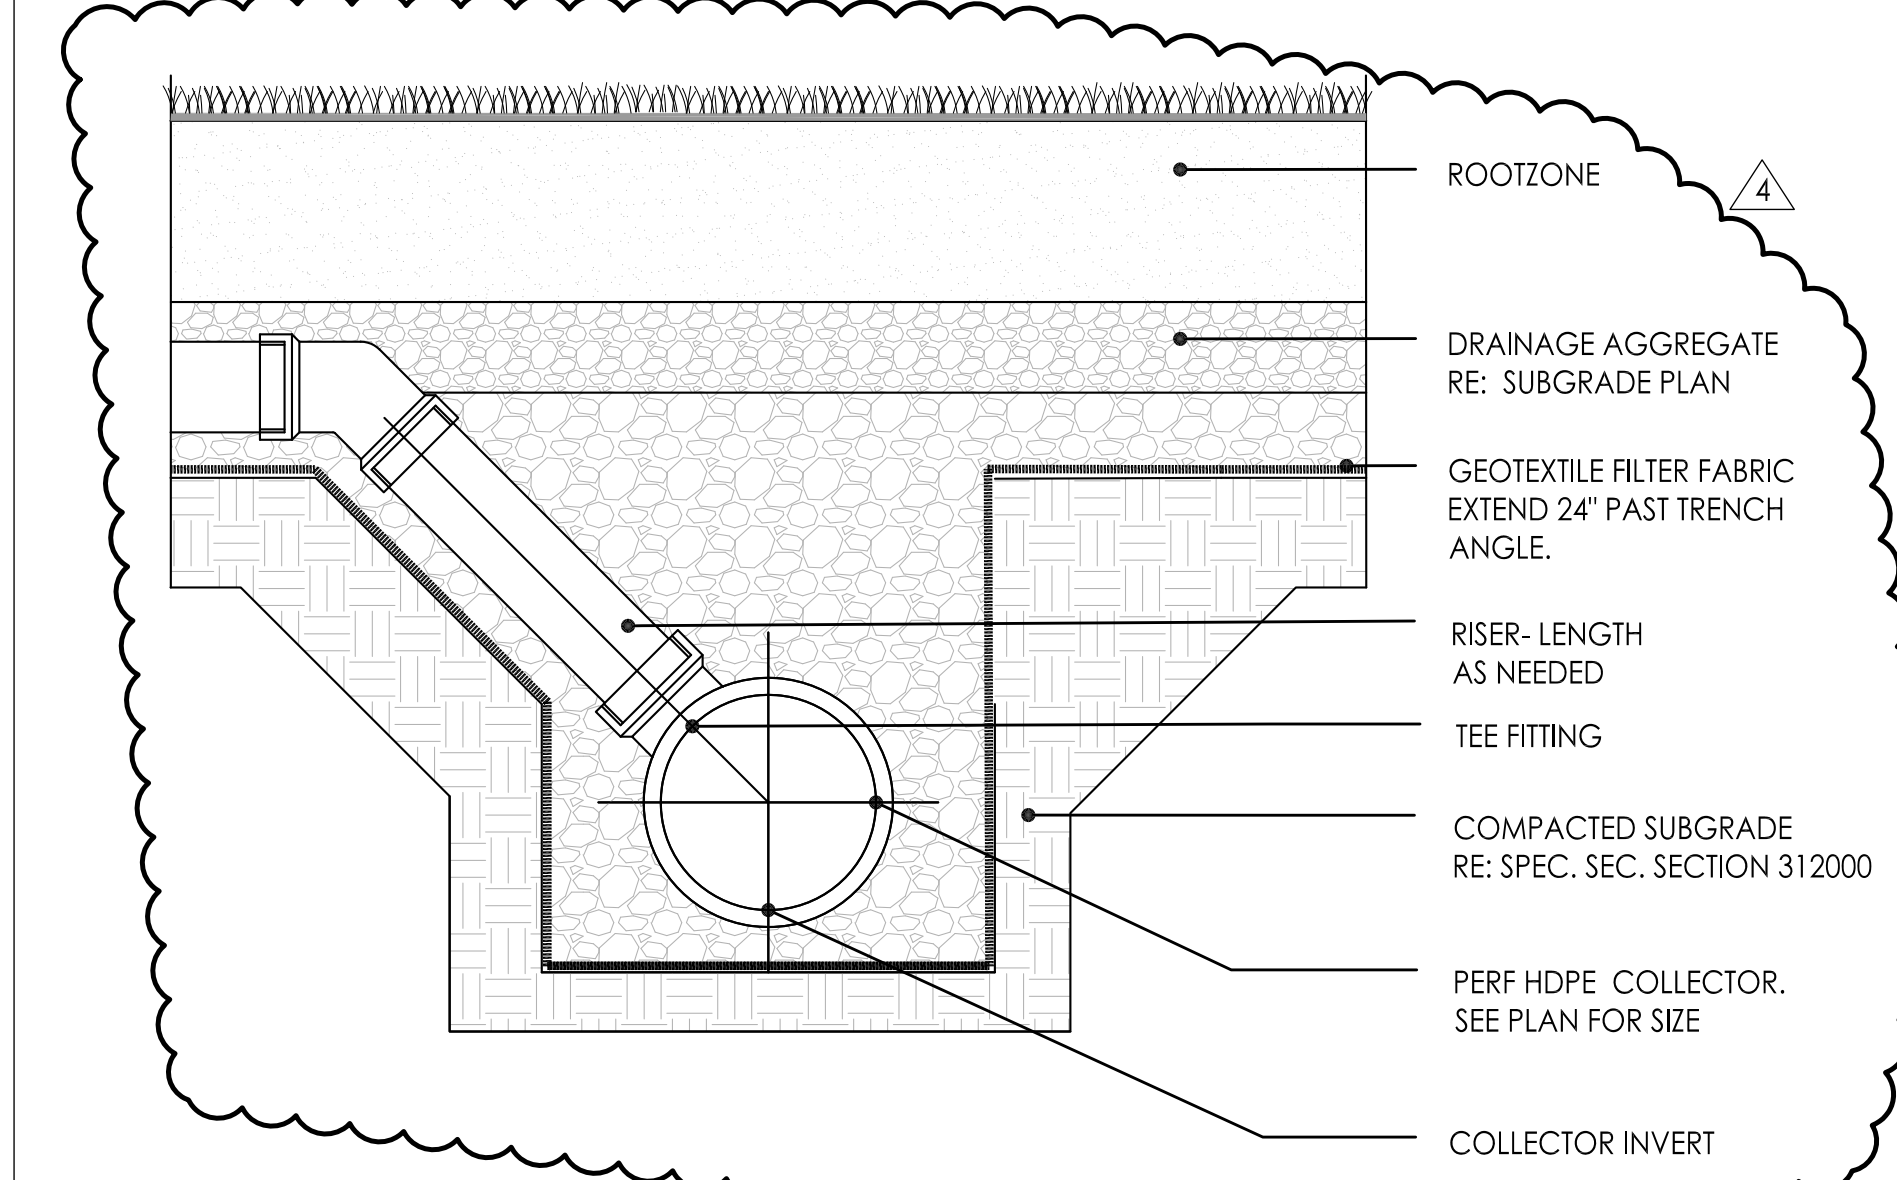

**7 COLLECTOR TRENCHING PIPE**  
 SCALE: 1 1/2" = 1'-0"

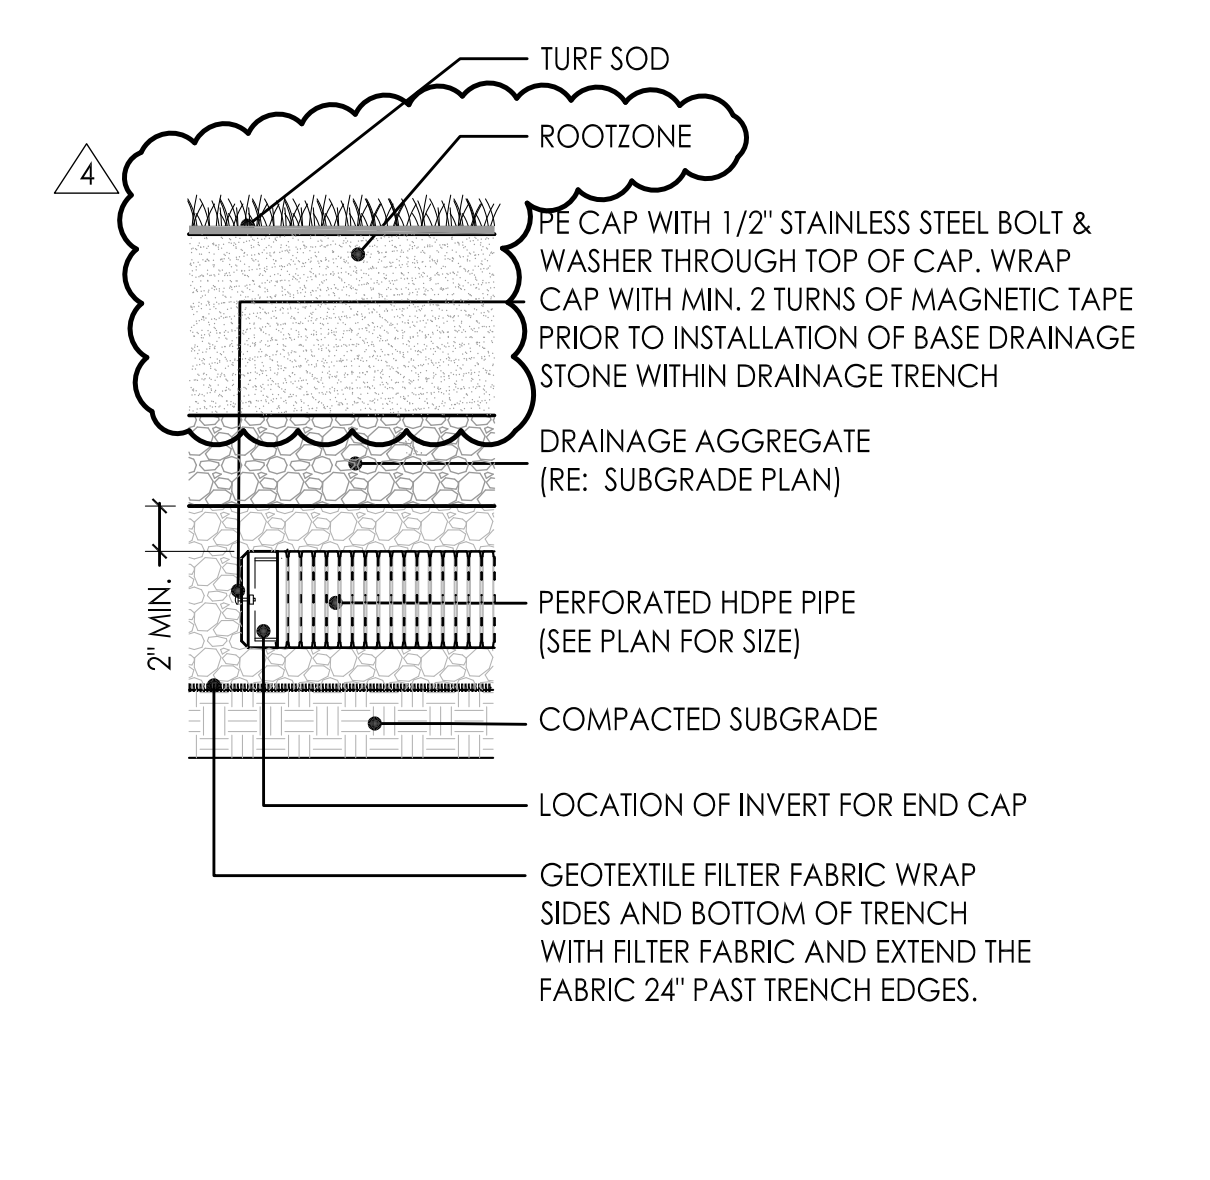

**8 SUBDRAINAGE PIPE CAP**  
 SCALE: 1 1/2" = 1'-0"

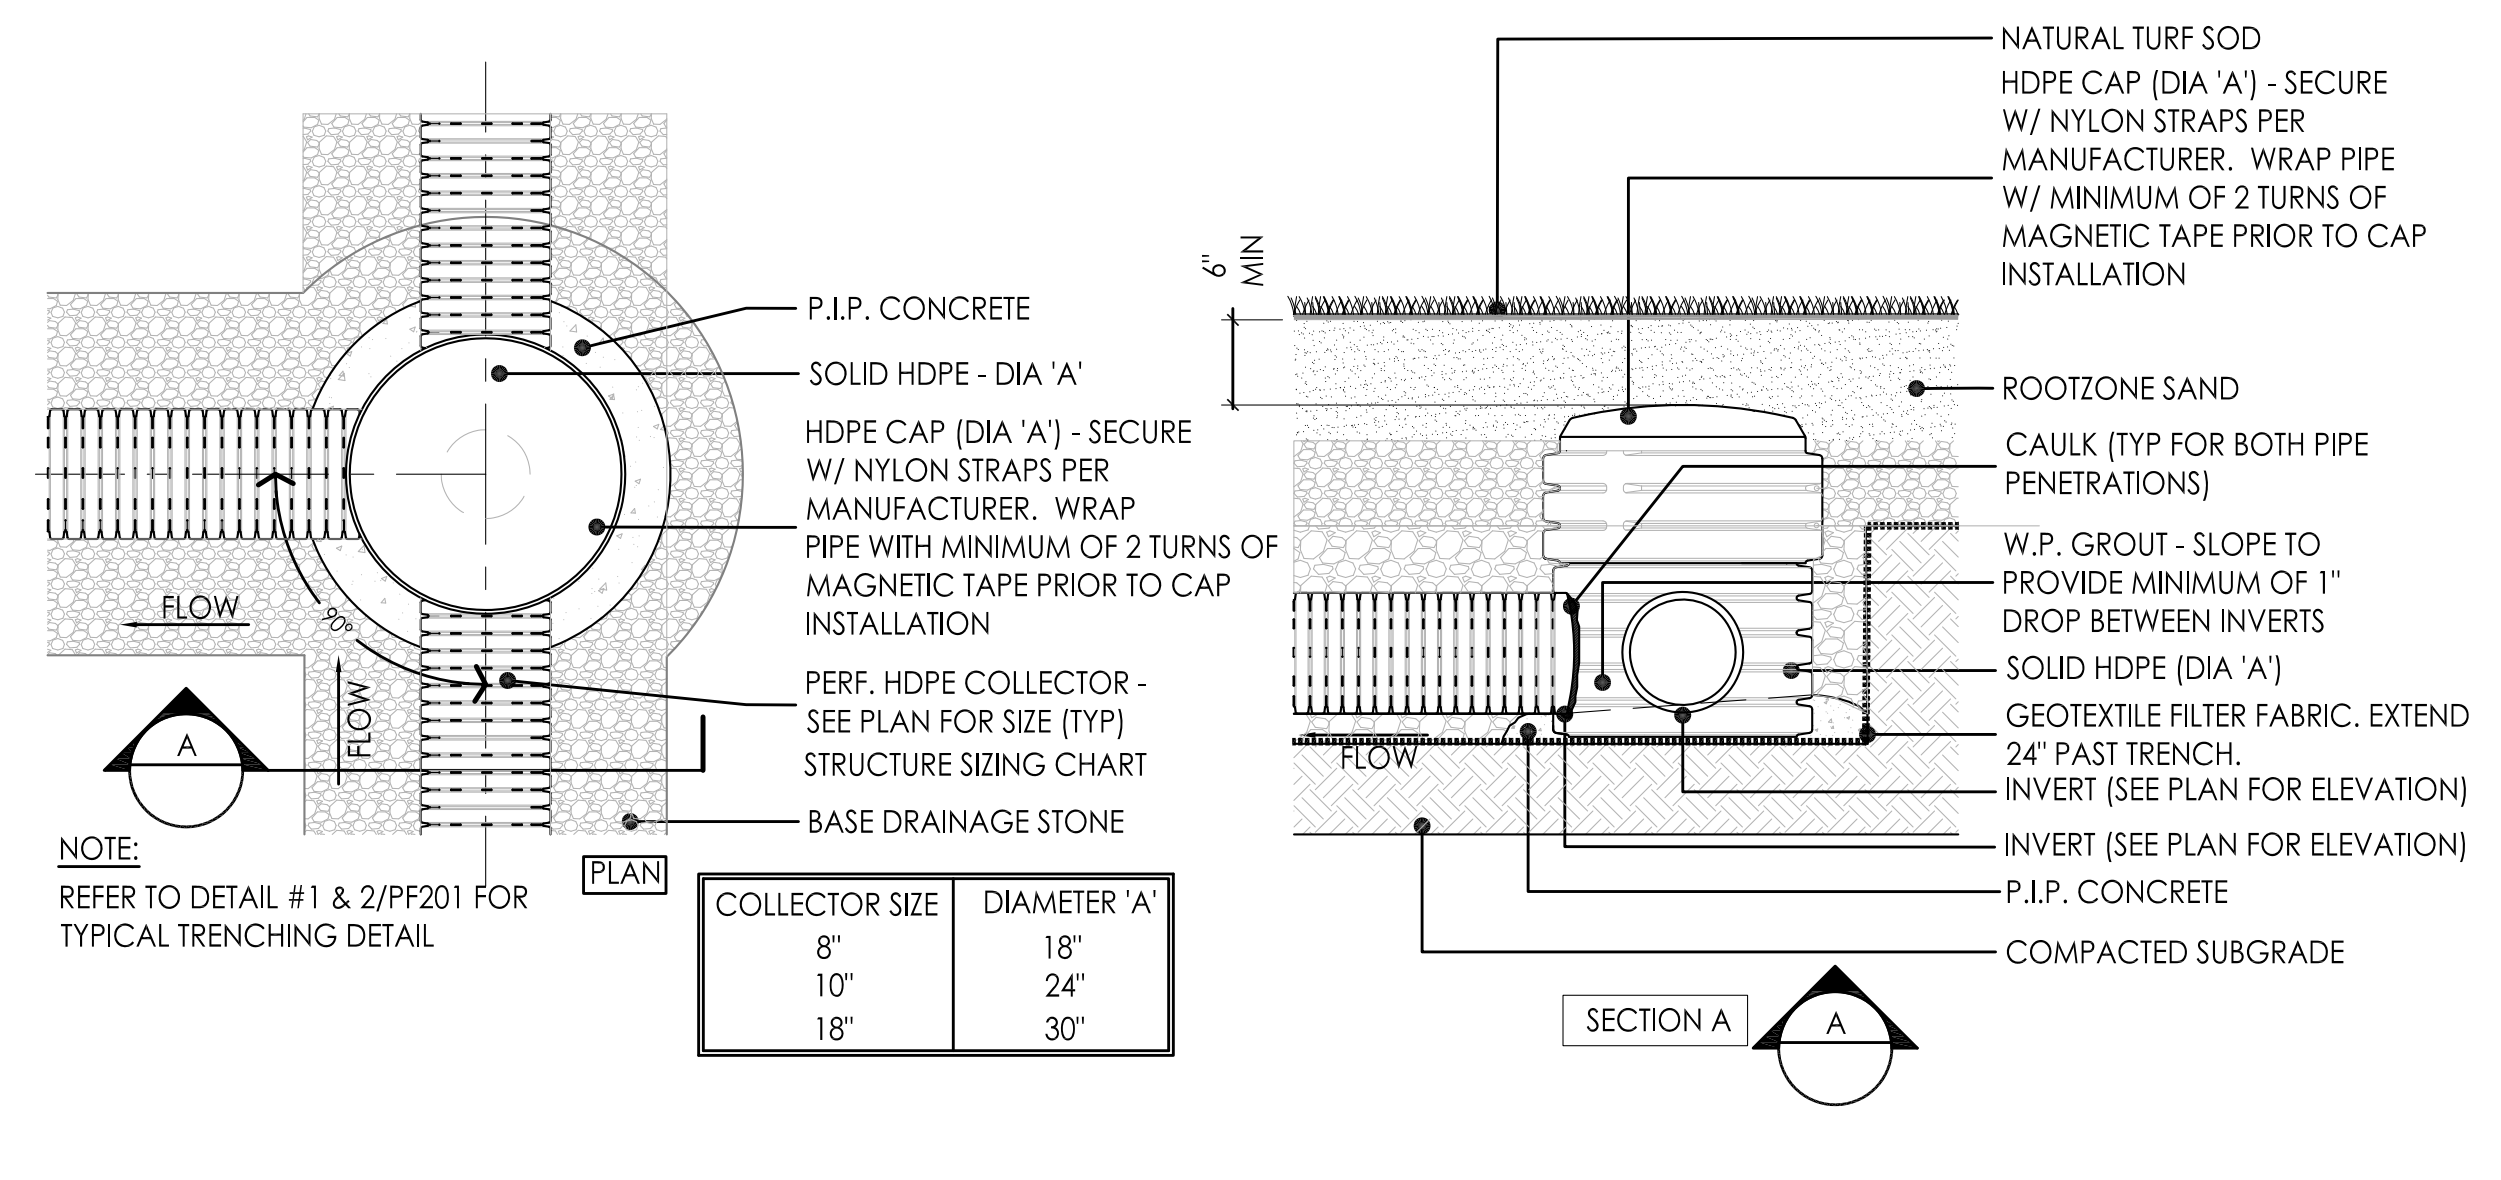

**6 DRAINAGE CLEANOUT**  
 SCALE: 1" = 1'-0"



<b>SKID AND ENVIRONMENTAL GRAPHICS</b> RAFAEL VINOLY ARCHITECTS 50 VANDAM STREET NEW YORK, NY 10013 T. 212.924.5060 F. 212.924.5858	<b>AV / IT SECURITY ENGINEER</b> M-E ENGINEERS 29 WEST 28TH STREET, 5TH FL NEW YORK, NY 10018 T. 212.447.6770	<b>TURF &amp; IRRIGATION CONSULTANT</b> JEFFREY L. BRUCE & CO. LLC 1807 SWIFT STREET, SUITE 204 NORTH KANSAS CITY, MI 64116 T. 212.447.8999	<b>CIVIL ENGINEER &amp; LANDSCAPE ARCHITECT</b> LANGAN 21 PENN PLAZA, 8TH FL NEW YORK, NY 10001-2727 T. 212.479.5400	<b>DISCLAIMER</b> THE ARCHITECT / ENGINEER SHALL HAVE NO RESPONSIBILITY FOR ANY LIABILITY, LOSS, COST, DAMAGE OR EXPENSE ARISING FROM OR RELATING TO ANY USE OF THIS DOCUMENT FOR ANY PURPOSE OTHER THAN ITS INTENDED PURPOSE ON THIS PROJECT. THIS DOCUMENT IS TO BE CONSIDERED IN CONJUNCTION WITH ALL RELATED DOCUMENTATION. ANY DISCREPANCIES IDENTIFIED IN THIS DOCUMENT MUST BE REPORTED IMMEDIATELY TO THE ARCHITECT / ENGINEER BEFORE PROCEEDING. CONTRACTORS MUST VERIFY ALL DIMENSIONS PRIOR TO PROCEEDING WITH ANY WORK. ONLY FIGURED DIMENSIONS ARE TO BE USED FOR VERIFICATION.	<b>ARCHITECT / ENGINEER SEAL</b> RAFAEL VINOLY ARCHITECTS 50 VANDAM STREET NEW YORK, NY 10013 T. 212.924.5060 F. 212.924.5858	<b>OWNER / CLIENT</b> NEW YORK CITY FOOTBALL CLUB 600 THIRD AVENUE NEW YORK, NY 10016 T. 212.738.5818	<b>PROJECT NAME &amp; LOCATION</b> CFA NEW YORK TRAINING FACILITY SUNY PURCHASE ANDERSON HILL 735 ROAD HARRISON, NY 10577	<b>KEY PLAN</b> 	<table border="1"> <thead> <tr> <th>REV. NO.</th> <th>DESCRIPTION</th> <th>DATE</th> </tr> </thead> <tbody> <tr> <td>1</td> <td>DOCUMENT RELEASE 01</td> <td>26-JUN-2014</td> </tr> <tr> <td>2</td> <td>DOCUMENT RELEASE 02</td> <td>03-JUL-2014</td> </tr> <tr> <td>3</td> <td>DOCUMENT RELEASE 03</td> <td>19-JUL-2014</td> </tr> <tr> <td>4</td> <td>DOCUMENT RELEASE 04</td> <td>31-JUL-2014</td> </tr> </tbody> </table>	REV. NO.	DESCRIPTION	DATE	1	DOCUMENT RELEASE 01	26-JUN-2014	2	DOCUMENT RELEASE 02	03-JUL-2014	3	DOCUMENT RELEASE 03	19-JUL-2014	4	DOCUMENT RELEASE 04	31-JUL-2014	<table border="1"> <thead> <tr> <th>PROJECT NUMBER</th> <th>DRAWING SIZE</th> <th>DRAWING SCALE</th> </tr> </thead> <tbody> <tr> <td>693,000</td> <td>30" x 42"</td> <td>AS NOTED</td> </tr> </tbody> </table>	PROJECT NUMBER	DRAWING SIZE	DRAWING SCALE	693,000	30" x 42"	AS NOTED	<b>DRAWING TITLE</b> PLAYING FIELD & SUBDRAINAGE DETAILS <b>DRAWING NUMBER</b> <b>PF.2.00</b> © 2014 RAFAEL VINOLY ARCHITECTS, P.C.
REV. NO.	DESCRIPTION	DATE																														
1	DOCUMENT RELEASE 01	26-JUN-2014																														
2	DOCUMENT RELEASE 02	03-JUL-2014																														
3	DOCUMENT RELEASE 03	19-JUL-2014																														
4	DOCUMENT RELEASE 04	31-JUL-2014																														
PROJECT NUMBER	DRAWING SIZE	DRAWING SCALE																														
693,000	30" x 42"	AS NOTED																														





TYPE OF SOIL DISTURBANCE	SOIL RESTORATION REQUIREMENT	COMMENTS/EXAMPLES
NO SOIL DISTURBANCE	RESTORATION NOT PERMITTED	PRESERVATION OF NATURAL FEATURES
MINIMAL SOIL DISTURBANCE	RESTORATION NOT REQUIRED	CLEARING AND GRUBBING
AREAS WHERE TOPSOIL IS STRIPPED ONLY (NO CHANGE IN GRADE)	HSG A&B*** APPLY 6" OF TOPSOIL	HSG C&D*** AERATE* AND APPLY 6" OF TOPSOIL
AREAS OF CUT OR FILL	HSG A&B*** AERATE* AND APPLY 6" OF TOPSOIL	HSG C&D*** APPLY FULL SOIL RESTORATION**
HEAVY TRAFFIC AREAS ON SITE (ESPECIALLY WITHIN 5-25 FEET AROUND BUILDINGS BUT NOT WITHIN 5 FEET OF PERIMETER FOUNDATION WALLS)	APPLY FULL SOIL RESTORATION** (DE-COMPACTION AND COMPOST ENHANCEMENT)	
AREAS WHERE RUNOFF REDUCTION AND/OR INFILTRATION PRACTICES ARE APPLIED	RESTORATION NOT REQUIRED, BUT MAY BE APPLIED TO ENHANCE THE REDUCTION SPECIFIED FOR APPROPRIATE PRACTICES	KEEP CONSTRUCTION EQUIPMENT FROM CROSSING THESE AREAS. TO PROTECT NEWLY INSTALLED PRACTICE FROM ONGOING CONSTRUCTION, CONSTRUCT A SINGLE PHASE OPERATION FENCE AREA.
REDEVELOPMENT PROJECTS	SOIL RESTORATION IS REQUIRED ON REDEVELOPMENT PROJECTS IN AREAS WHERE EXISTING IMPERVIOUS AREA WILL BE CONVERTED TO PERVIOUS AREA	

\* AERATION INCLUDES THE USE OF MACHINES SUCH AS TRACTOR-DRAWN IMPLEMENTS WITH COULTERS MAKING A NARROW SILT IN THE SOIL, A ROLLER WITH MANY SKIPES MAKING INDENTATIONS IN THE SOIL, OR PRONGS WHICH FUNCTION LIKE A MINI-SUBSOILER  
 \*\* PER "DEEP RIPPING AND DE-COMPACTION, DEC 2008"  
 \*\*\* HYDROLOGIC SOIL GROUP (HSG) ACCORDING TO THE NATIONAL RESOURCE CONSERVATION SERVICE.

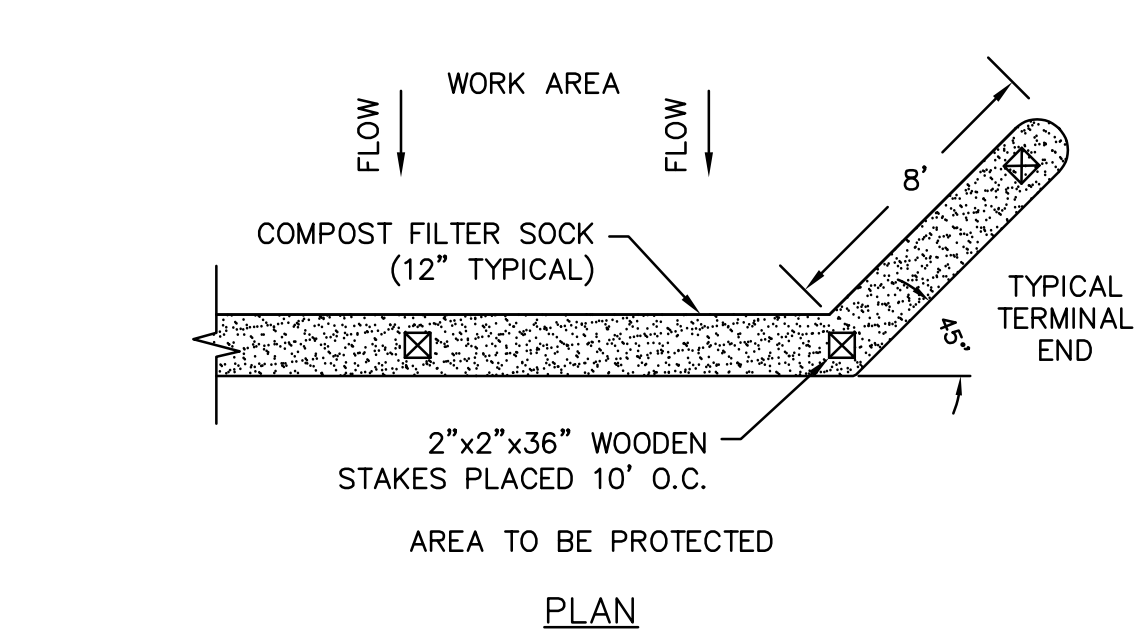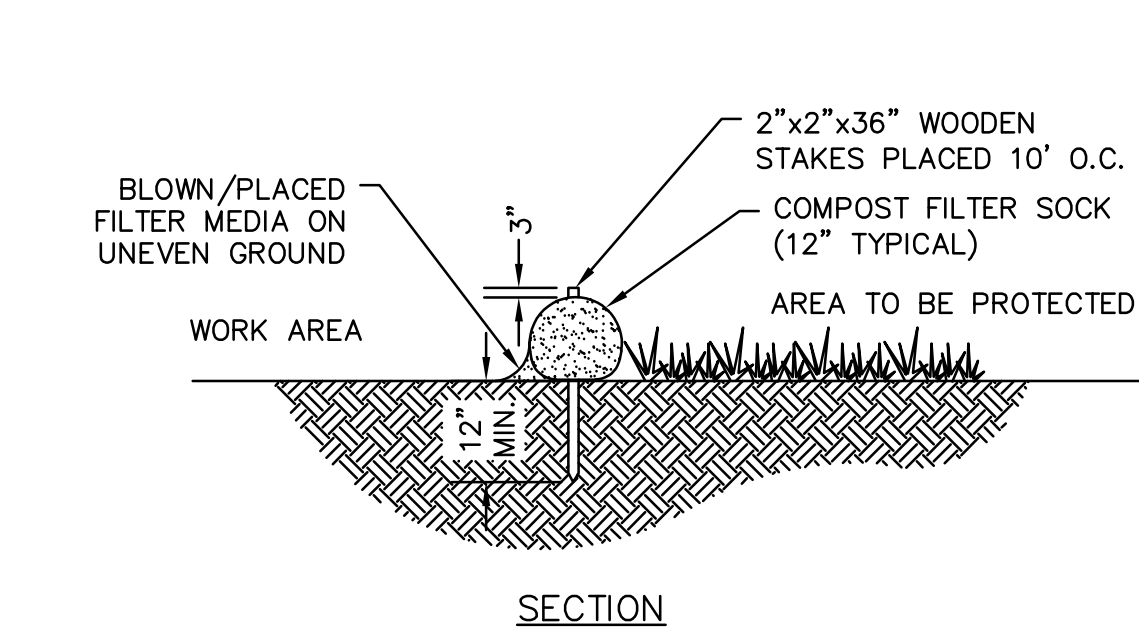


**NOTES:**  
 1. COMPOST FILTER SOCKS SHALL BE FILTREXX SILTSOXX OR EQUIVALENT.  
 2. THE COMPOST FILTER SOCK SHALL MEET THE REQUIREMENTS IN THE NEW YORK STANDARD SPECIFICATION FOR EROSION AND SEDIMENT CONTROL.  
 3. THE COMPOST INFILL SHALL MEET THE PHYSICAL PARAMETERS IN TABLE 5.3-COMPOST STANDARDS TABLE.  
 4. SOCKS MAY BE FILLED AFTER PLACEMENT BY BLOWING COMPOST INTO THE TUBE PNEUMATICALLY, OR FILLED AT A STAGING LOCATION AND MOVED INTO THE DESIGNED LOCATION.  
 5. MAINTENANCE SHALL BE PERFORMED AS NEEDED AND ACCUMULATED SEDIMENT REMOVED WHEN IT REACHES HALF THE ABOVE GROUND HEIGHT.  
 6. COMPOST FILTER SOCKS SHALL BE USED WHERE EROSION COULD OCCUR IN THE FORM OF SHEET EROSION.  
 7. UPON STABILIZATION OF THE CONTRIBUTING AREA, THE STAKES SHALL BE REMOVED, THE SOCKS SHALL BE REMOVED BY CUTTING THE MESH AND THE COMPOST SPREAD AS AN ADDITIONAL MULCH TO ACT AS A SOIL SUPPLEMENT.  
 8. MAXIMUM ALLOWABLE SLOPE LENGTHS CONTRIBUTING RUN-OFF TO A 12" COMPOST FILTER SOCK ARE:

% SLOPE	MAXIMUM SLOPE LENGTH(FT)
2	250
5	125
10	225
20	125
25	65
35	50
40	40
50	25

### 1 COMPOST FILTER SOCK INSTALLATION

CS 4.53 SCALE: NOT TO SCALE


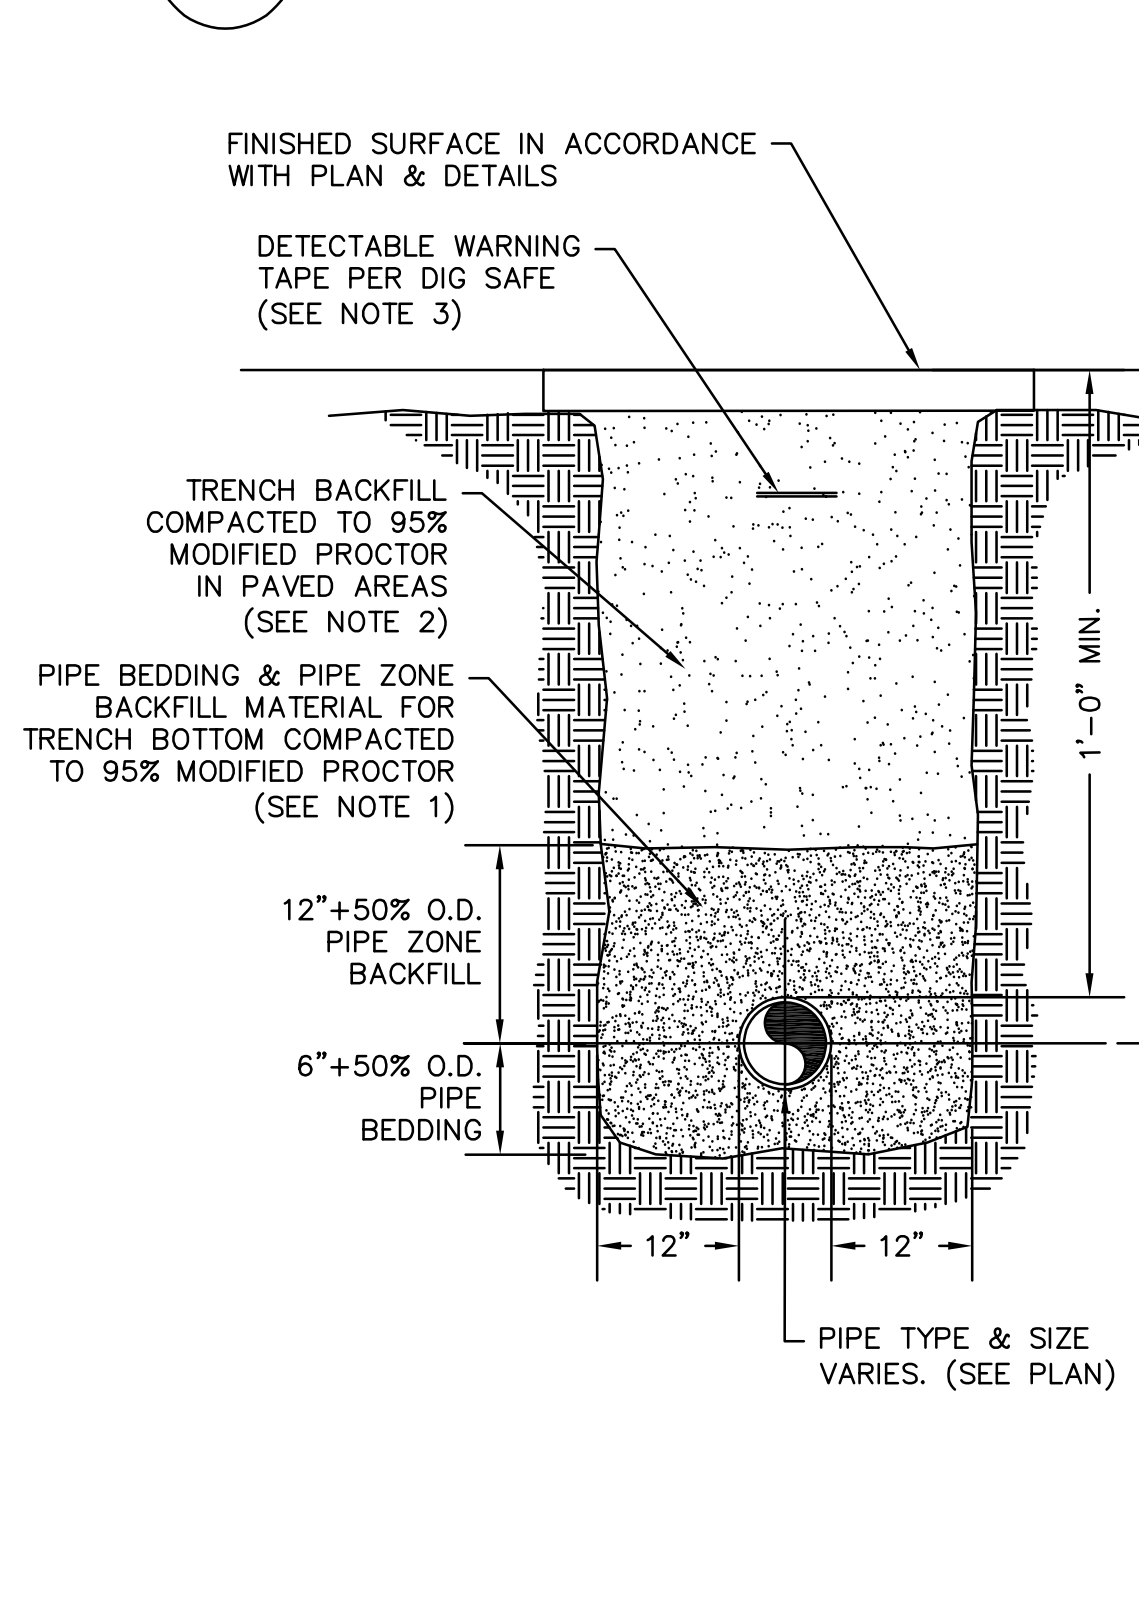


### 4 PIPE TRENCH DETAIL (TYPICAL)


CS 4.53 SCALE: NOT TO SCALE

TYPE OF SOIL DISTURBANCE	SOIL RESTORATION REQUIREMENT	COMMENTS/EXAMPLES
NO SOIL DISTURBANCE	RESTORATION NOT PERMITTED	PRESERVATION OF NATURAL FEATURES
MINIMAL SOIL DISTURBANCE	RESTORATION NOT REQUIRED	CLEARING AND GRUBBING
AREAS WHERE TOPSOIL IS STRIPPED ONLY (NO CHANGE IN GRADE)	HSG A&B*** APPLY 6" OF TOPSOIL	HSG C&D*** AERATE* AND APPLY 6" OF TOPSOIL
AREAS OF CUT OR FILL	HSG A&B*** AERATE* AND APPLY 6" OF TOPSOIL	HSG C&D*** APPLY FULL SOIL RESTORATION**
HEAVY TRAFFIC AREAS ON SITE (ESPECIALLY WITHIN 5-25 FEET AROUND BUILDINGS BUT NOT WITHIN 5 FEET OF PERIMETER FOUNDATION WALLS)	APPLY FULL SOIL RESTORATION** (DE-COMPACTION AND COMPOST ENHANCEMENT)	
AREAS WHERE RUNOFF REDUCTION AND/OR INFILTRATION PRACTICES ARE APPLIED	RESTORATION NOT REQUIRED, BUT MAY BE APPLIED TO ENHANCE THE REDUCTION SPECIFIED FOR APPROPRIATE PRACTICES	KEEP CONSTRUCTION EQUIPMENT FROM CROSSING THESE AREAS. TO PROTECT NEWLY INSTALLED PRACTICE FROM ONGOING CONSTRUCTION, CONSTRUCT A SINGLE PHASE OPERATION FENCE AREA.
REDEVELOPMENT PROJECTS	SOIL RESTORATION IS REQUIRED ON REDEVELOPMENT PROJECTS IN AREAS WHERE EXISTING IMPERVIOUS AREA WILL BE CONVERTED TO PERVIOUS AREA	

\* AERATION INCLUDES THE USE OF MACHINES SUCH AS TRACTOR-DRAWN IMPLEMENTS WITH COULTERS MAKING A NARROW SILT IN THE SOIL, A ROLLER WITH MANY SKIPES MAKING INDENTATIONS IN THE SOIL, OR PRONGS WHICH FUNCTION LIKE A MINI-SUBSOILER  
 \*\* PER "DEEP RIPPING AND DE-COMPACTION, DEC 2008"  
 \*\*\* HYDROLOGIC SOIL GROUP (HSG) ACCORDING TO THE NATIONAL RESOURCE CONSERVATION SERVICE.

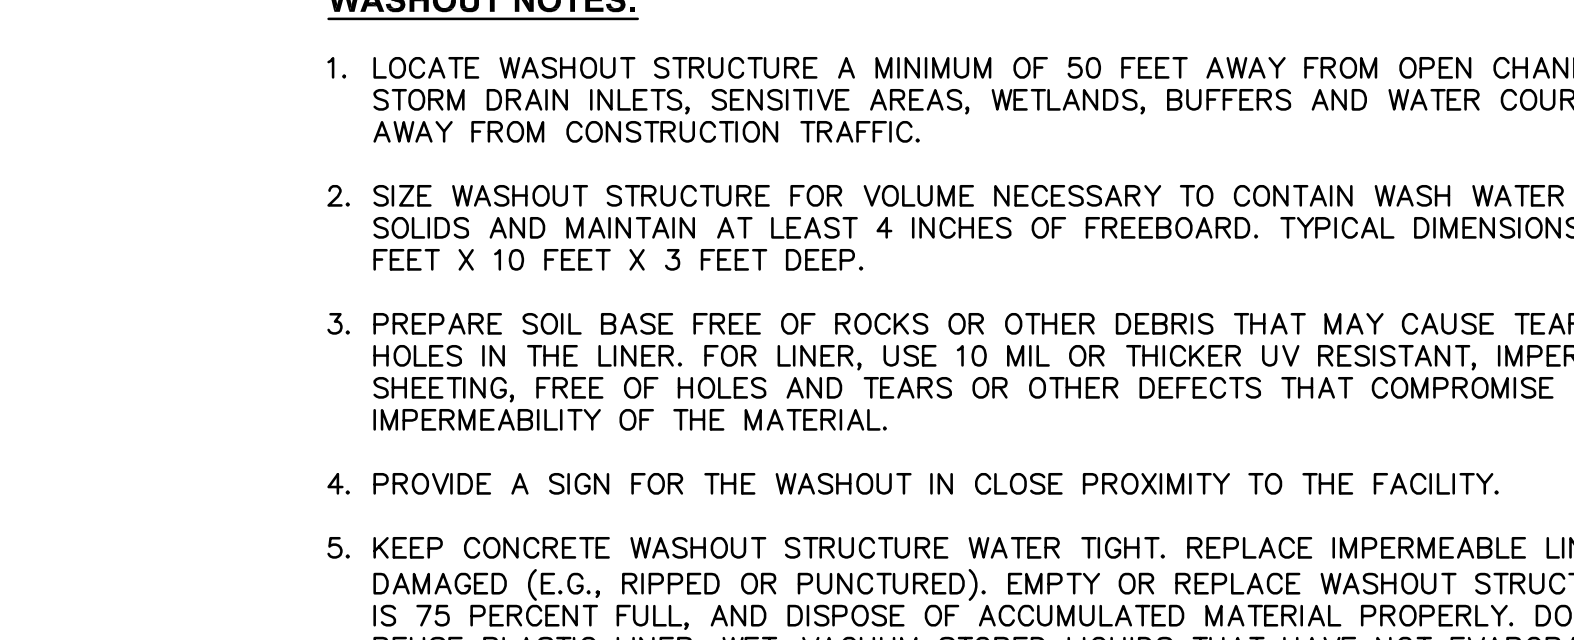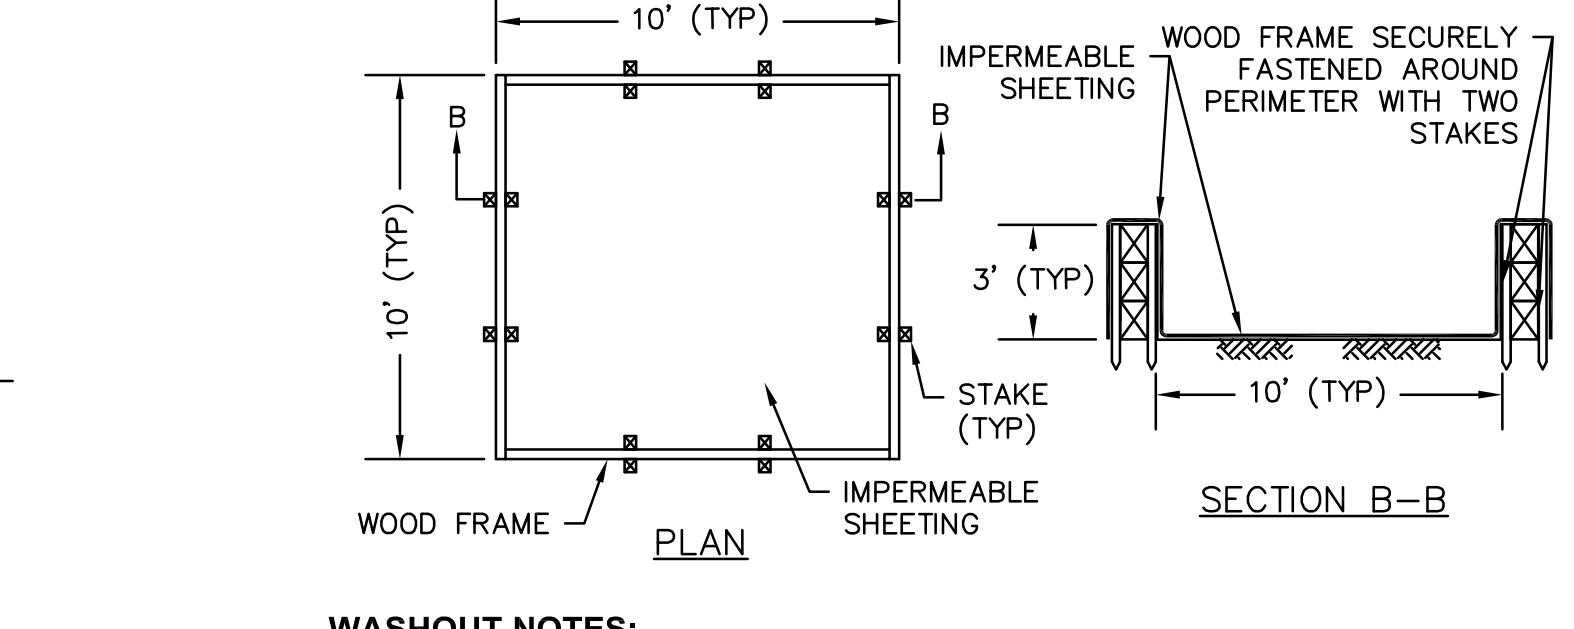


**NOTES:**  
 1. YARD DRAIN STRUCTURES SHALL BE DESIGNED BY THE MANUFACTURER AND INSTALLED PER MANUFACTURER'S RECOMMENDATION. NYLOPLAST SYSTEM BY ADS USED AS DESIGN BASIS, EQUIVALENT SUBSTITUTIONS ACCEPTED.

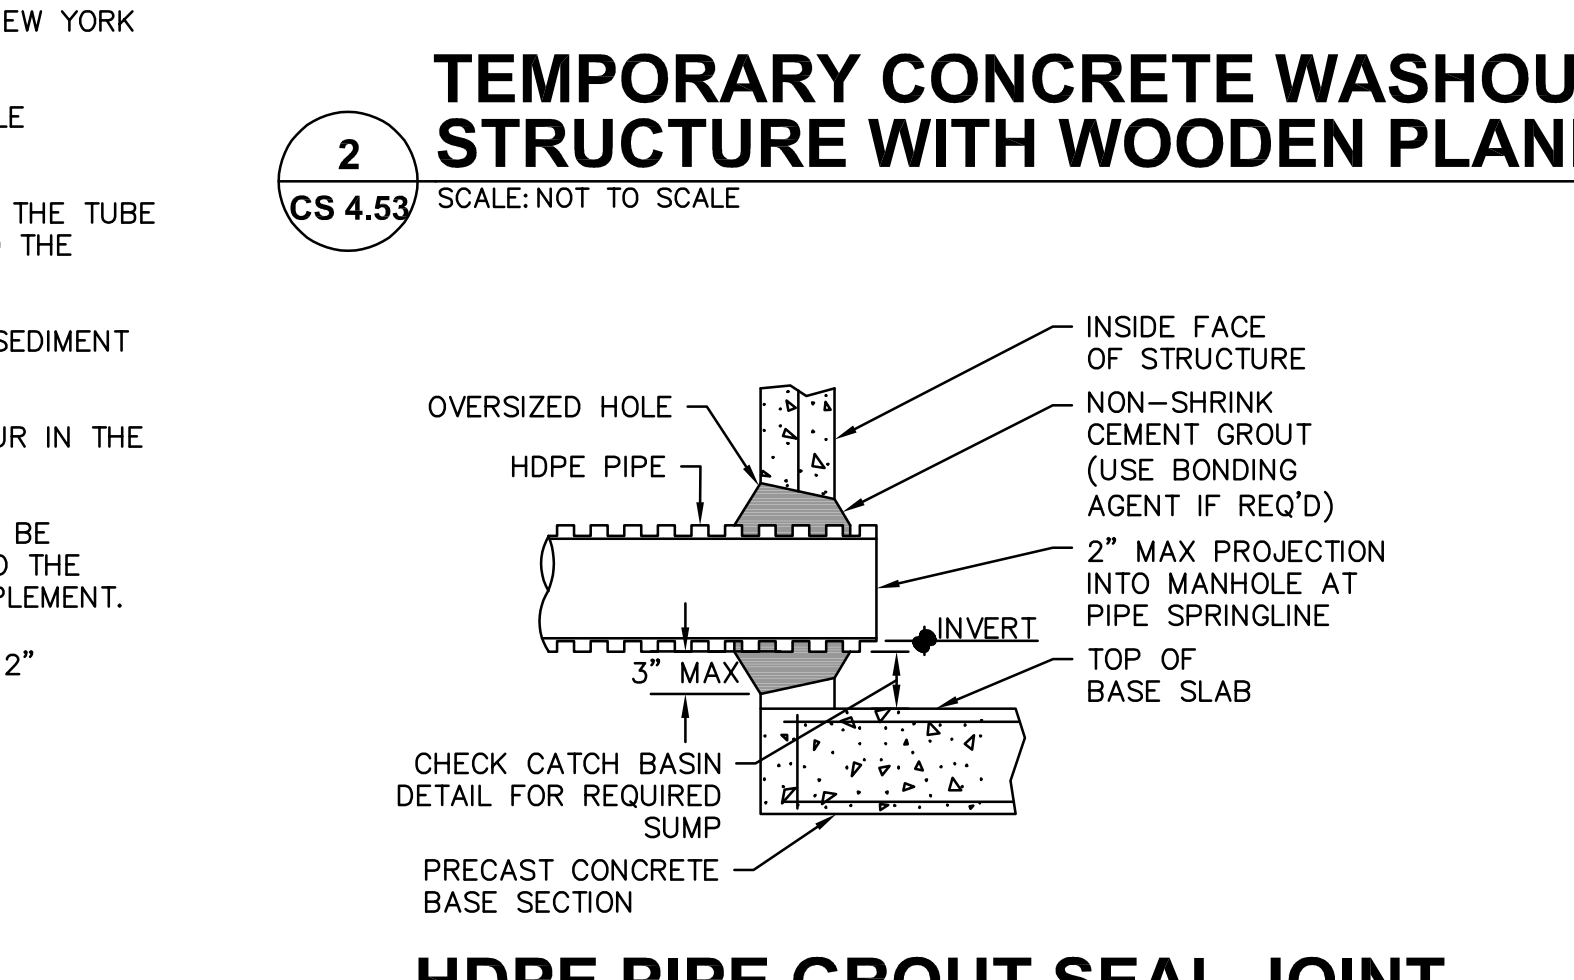


### 7 END SECTION STONE LINED APRON

CS 4.53 SCALE: NOT TO SCALE


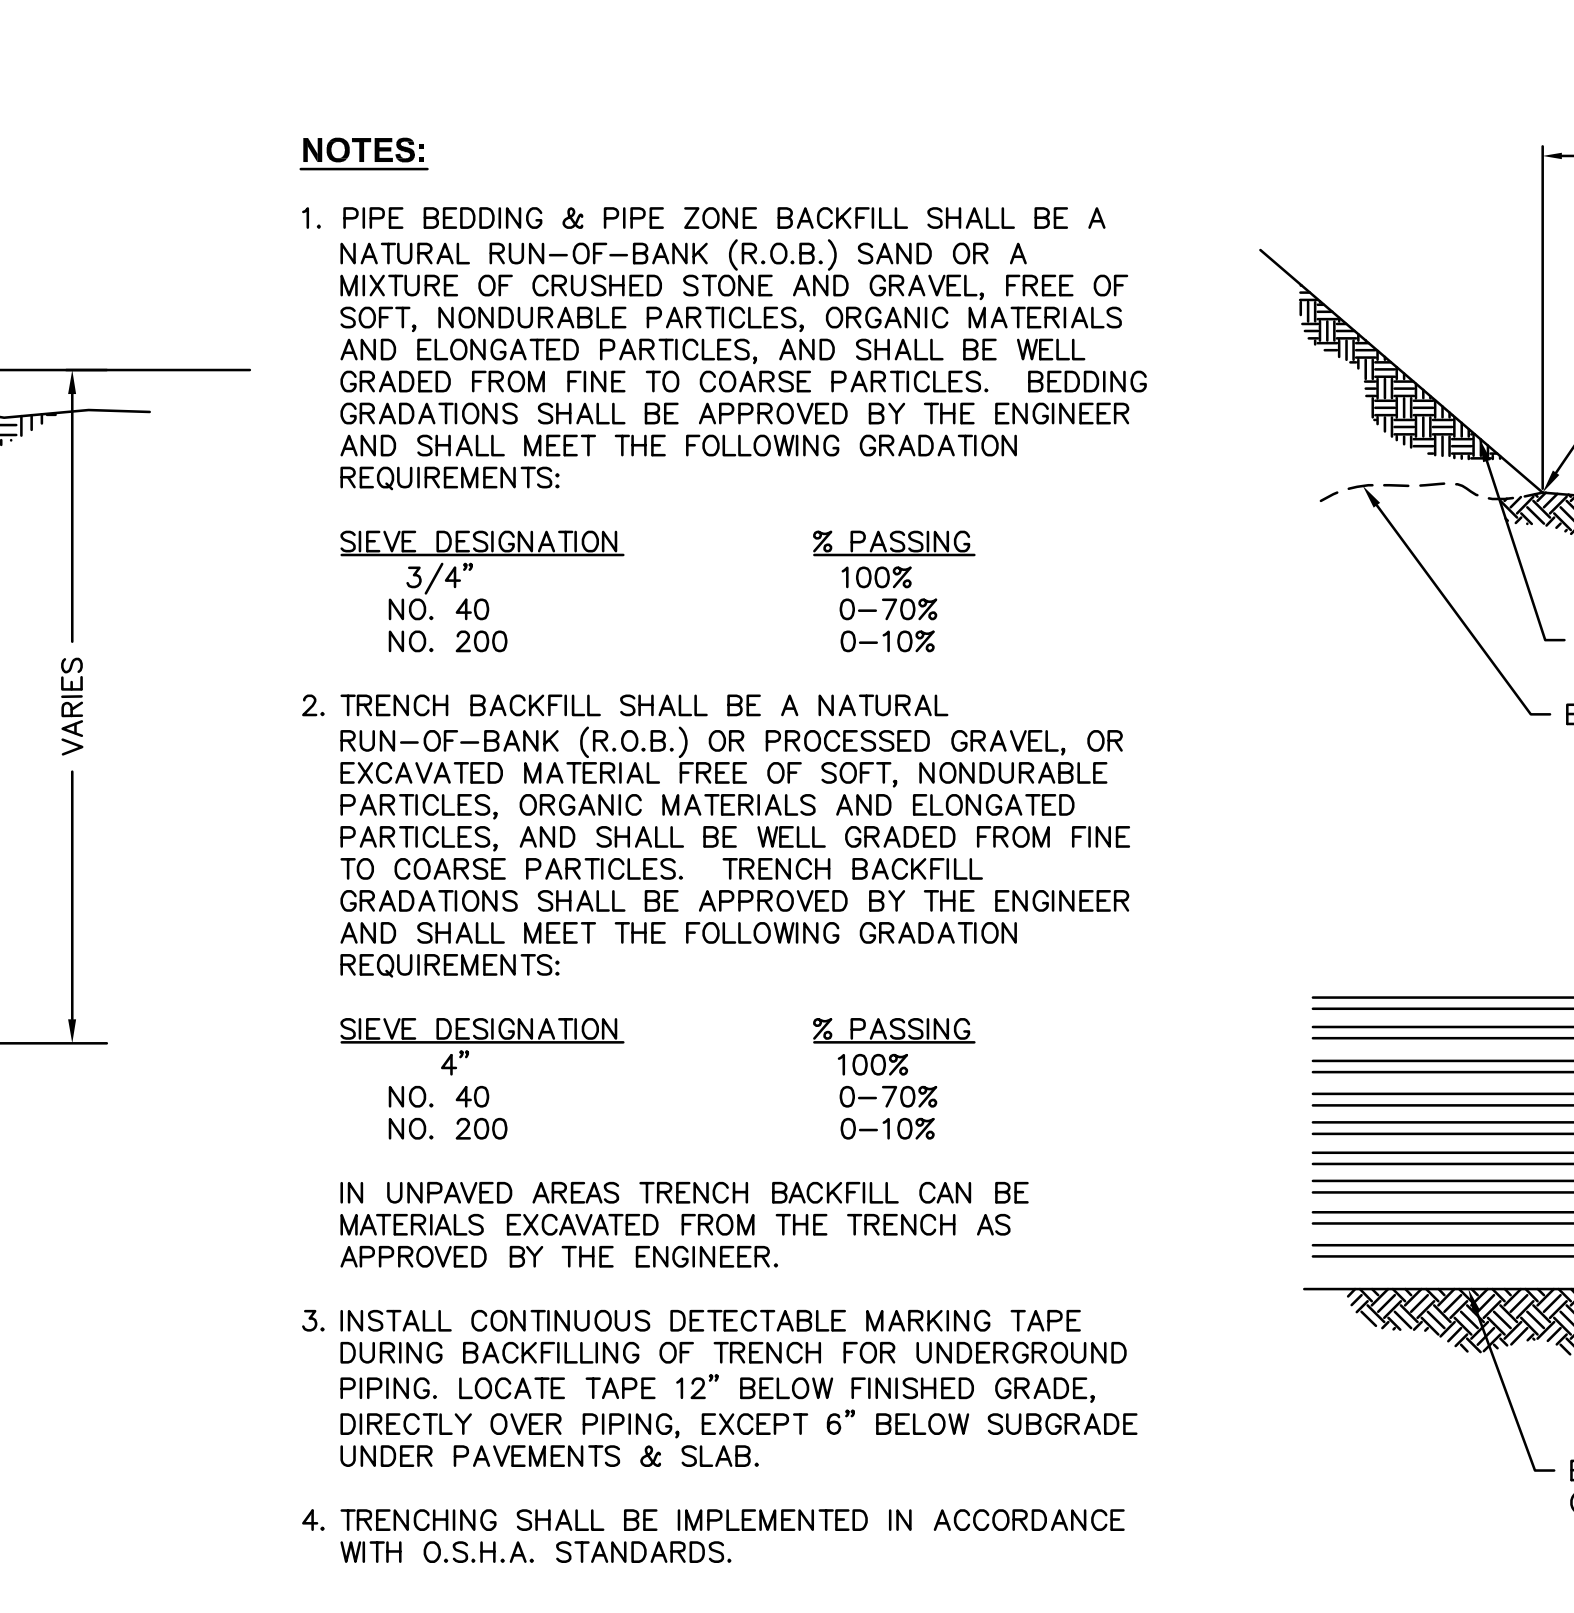


### 9 ANCHORED STABILIZATION MATTING


CS 4.53 SCALE: NOT TO SCALE

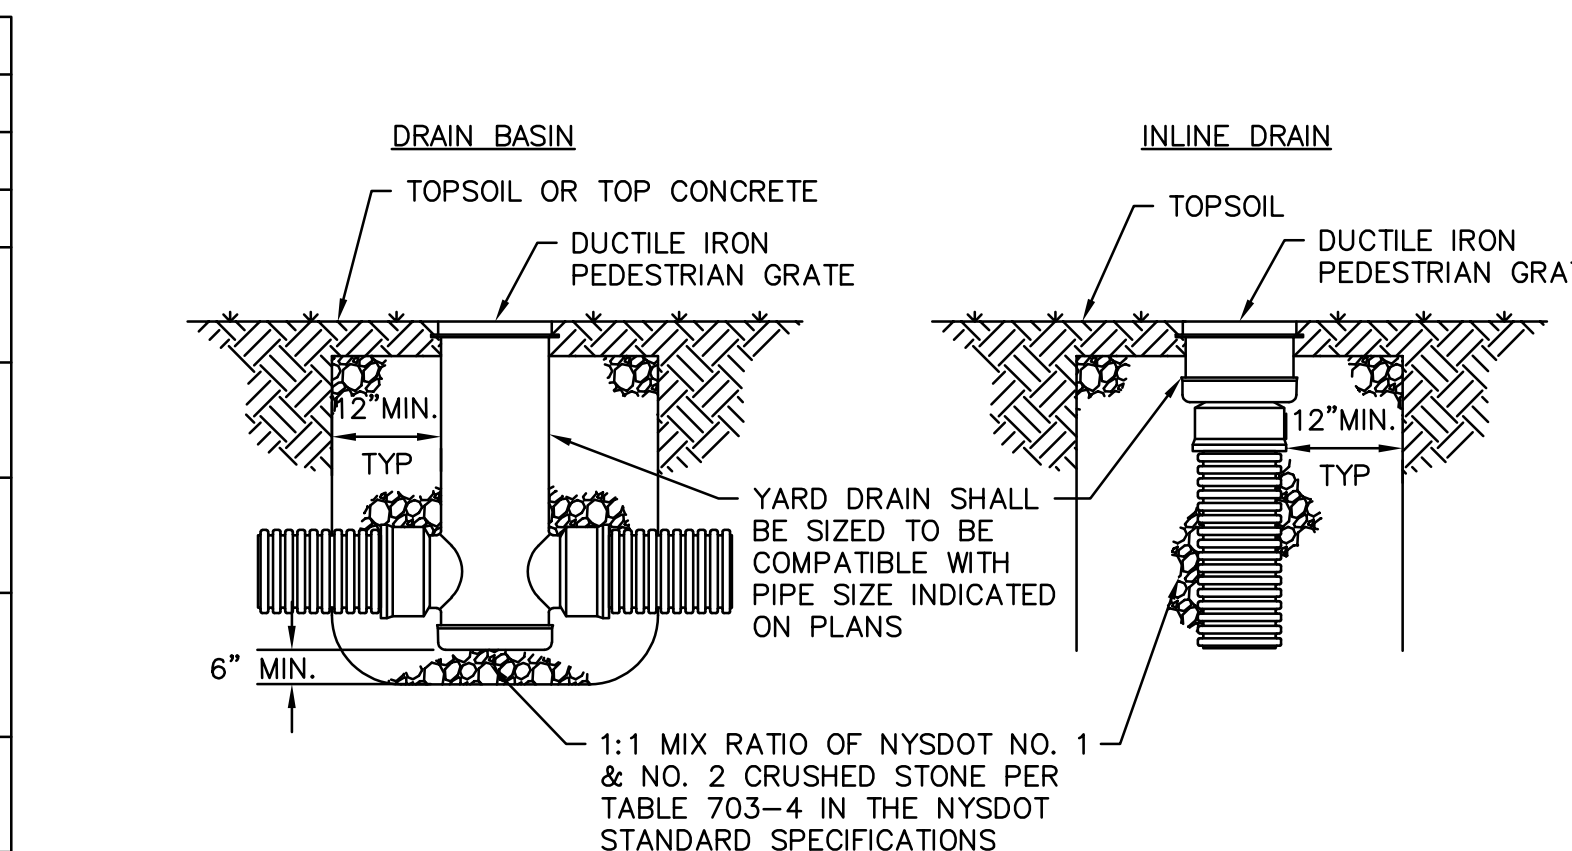

**WASHOUT NOTES:**  
 1. LOCATE WASHOUT STRUCTURE A MINIMUM OF 50 FEET AWAY FROM OPEN CHANNELS, STORM DRAIN INLETS, SENSITIVE AREAS, WETLANDS, BUFFERS AND WATER COURSES AND AWAY FROM CONSTRUCTION TRAFFIC.  
 2. SIZE WASHOUT STRUCTURE FOR VOLUME NECESSARY TO CONTAIN WASH WATER AND SOLIDS AND MAINTAIN AT LEAST 4 INCHES OF FREEBOARD. TYPICAL DIMENSIONS ARE 10 FEET X 10 FEET X 3 FEET DEEP.  
 3. PREPARE SOIL BASE FREE OF ROCKS OR OTHER DEBRIS THAT MAY CAUSE TEARS OR HOLES IN THE LINER. FOR LINER, USE 10 MIL OR THICKER UV RESISTANT IMPERMEABLE SHEETING, FREE OF HOLES AND TEARS OR OTHER DEFECTS THAT COMPROMISE IMPERMEABILITY OF THE MATERIAL.  
 4. PROVIDE A SIGN FOR THE WASHOUT IN CLOSE PROXIMITY TO THE FACILITY.  
 5. KEEP CONCRETE WASHOUT STRUCTURE WATER TIGHT. REPLACE IMPERMEABLE LINER IF DAMAGED (E.G., RIPPED OR PUNCTURED). EMPTY OR REPLACE WASHOUT STRUCTURE THAT IS 75 PERCENT FULL, AND DISPOSE OF ACCUMULATED MATERIAL PROPERLY. DO NOT REUSE PLASTIC LINER. WET-VACUUM STORED LIQUIDS THAT HAVE NOT EVAPORATED AND DISPOSE OF IN AN APPROVED MANNER. PRIOR TO FORECASTED RAINSTORMS, REMOVE LIQUIDS OR COVER STRUCTURE TO PREVENT OVERFLOWS. REMOVE HARDENED SOLIDS, WHOLE OR BROKEN UP, FOR DISPOSAL OR RECYCLING. MAINTAIN RUNOFF DIVERSION AROUND EXCAVATED WASHOUT STRUCTURE UNTIL STRUCTURE IS REMOVED.

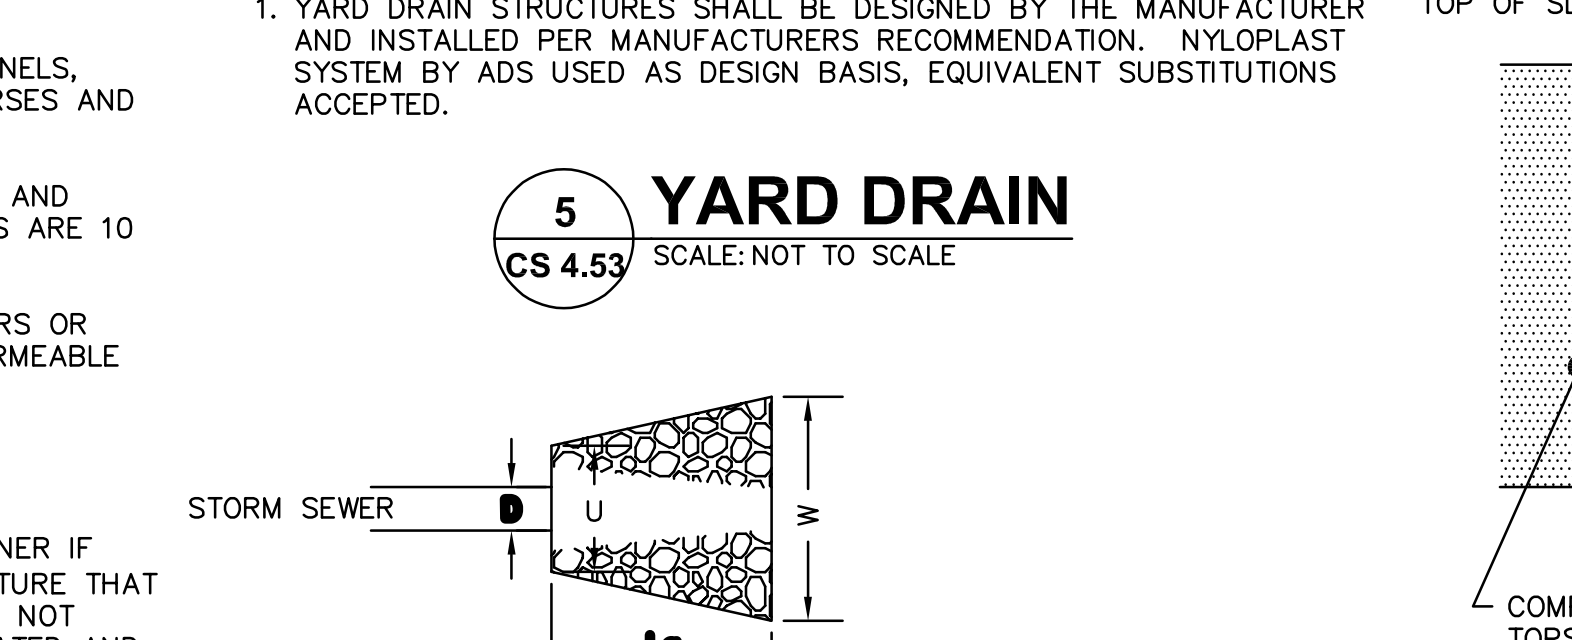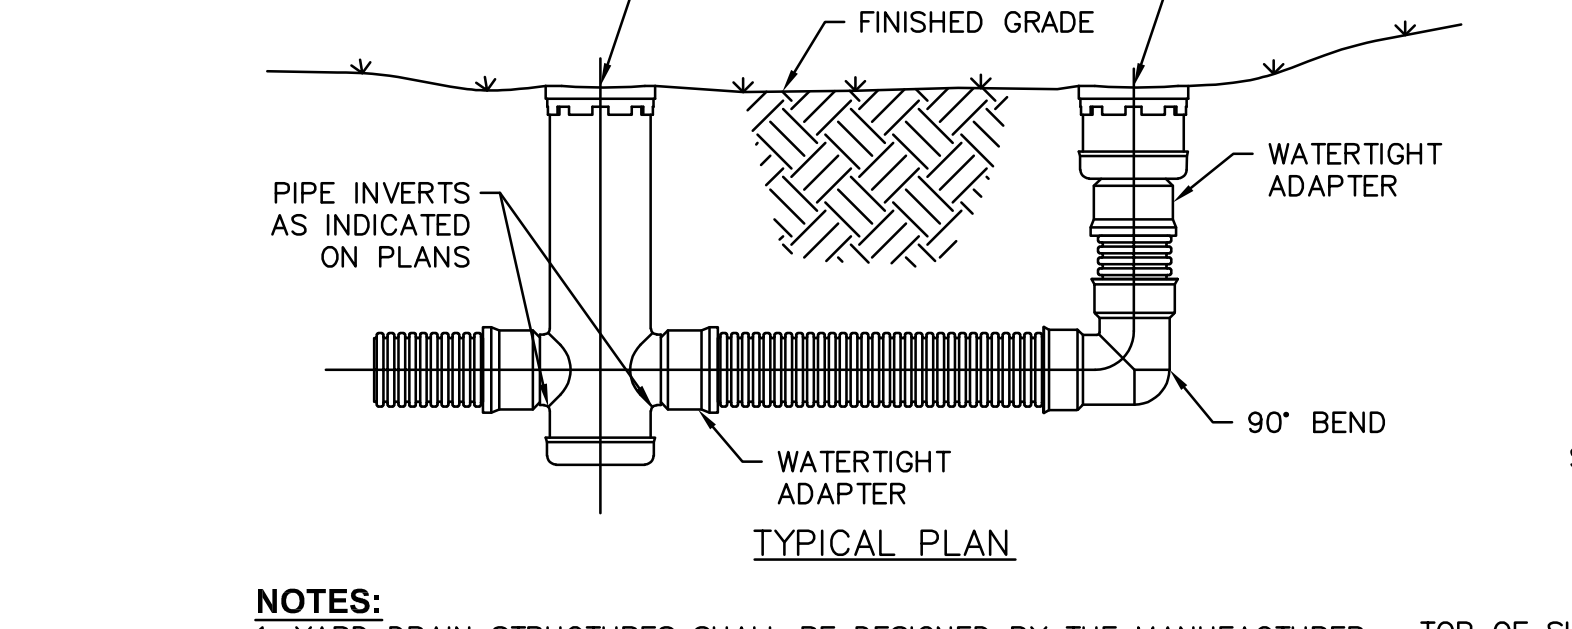


**NOTES:**  
 1. SIGNS SHALL BE PLACED EVERY 50 FEET.  
 2. SIGN BACKGROUND WILL BE ORANGE WITH BLACK LETTERING. SIGN SHALL BE 3/4" BLACK DOOR RATED PLYWOOD OR SIMILAR MATERIAL.  
 3. FENCE SHALL BE ATTACHED TO POSTS PER MANUFACTURER'S RECOMMENDATIONS.  
 4. TREE/VEGETATION PROTECTION BARRIER SHALL BE INSTALLED IN THE LOCATIONS SHOWN ON THE PLANS OR A.O.B.E. PRIOR TO BEGINNING ANY WORK IN THESE AREAS AND MAINTAINED THROUGHOUT ITS DURATION.  
 5. IN AREAS ADJACENT TO OR WITHIN A WETLAND, THE TREE/VEGETATION BARRIER SHALL BE PLACED IN COMBINATION WITH THE PERIMETER SEDIMENT BARRIER.

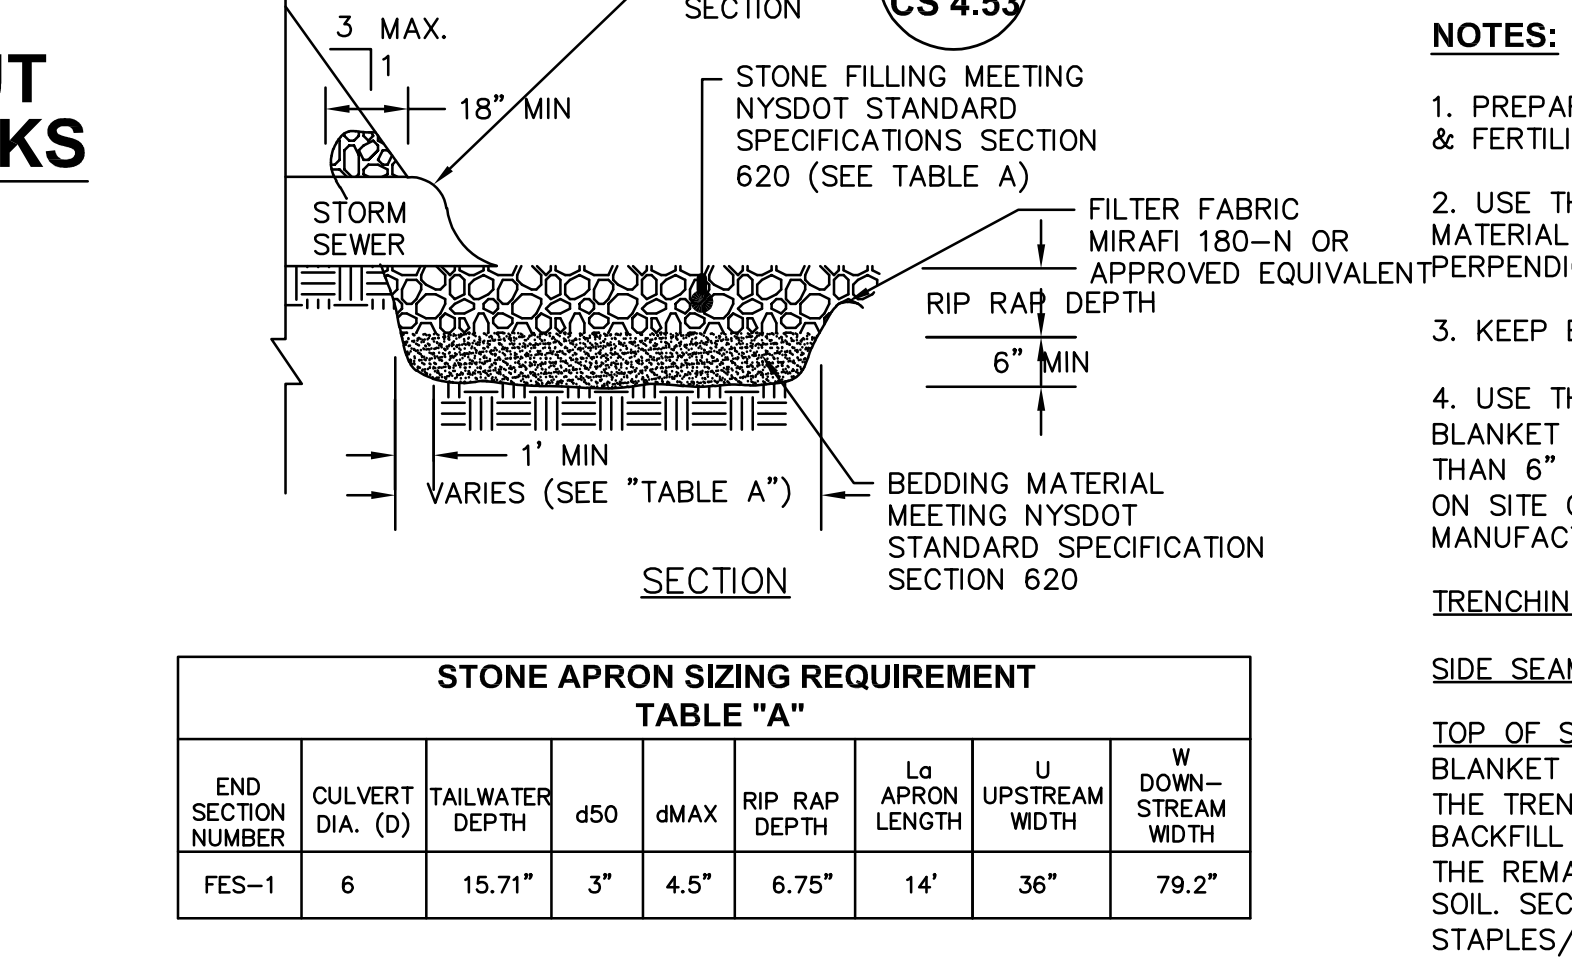


### 10 TEMPORARY PLASTIC BARRIER FENCE

CS 4.53 SCALE: NOT TO SCALE


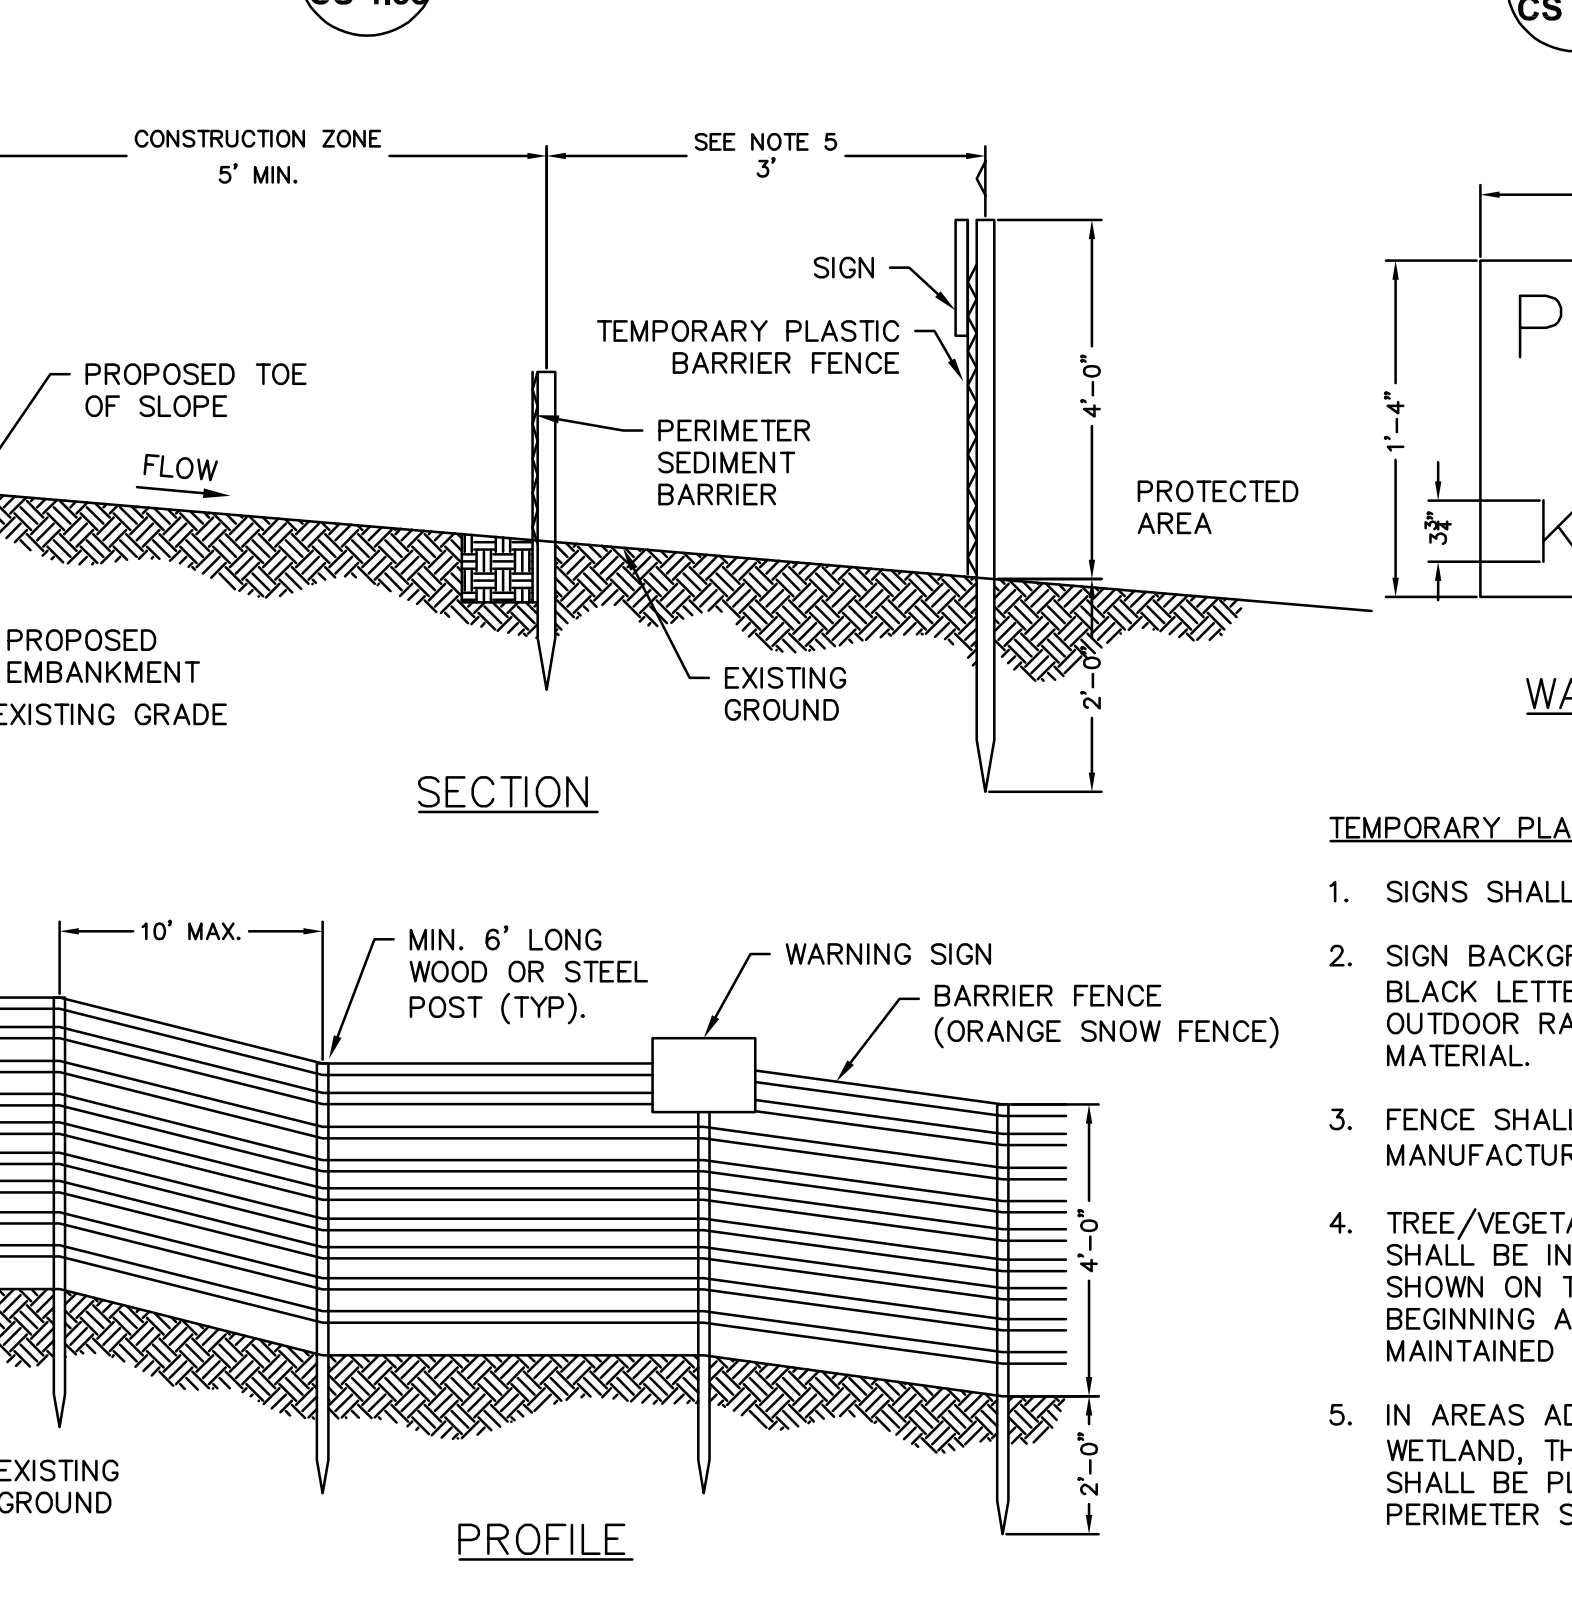


### 6 COMPOST FILTER SOCK INLET PROTECTION DETAIL


CS 4.53 SCALE: NOT TO SCALE

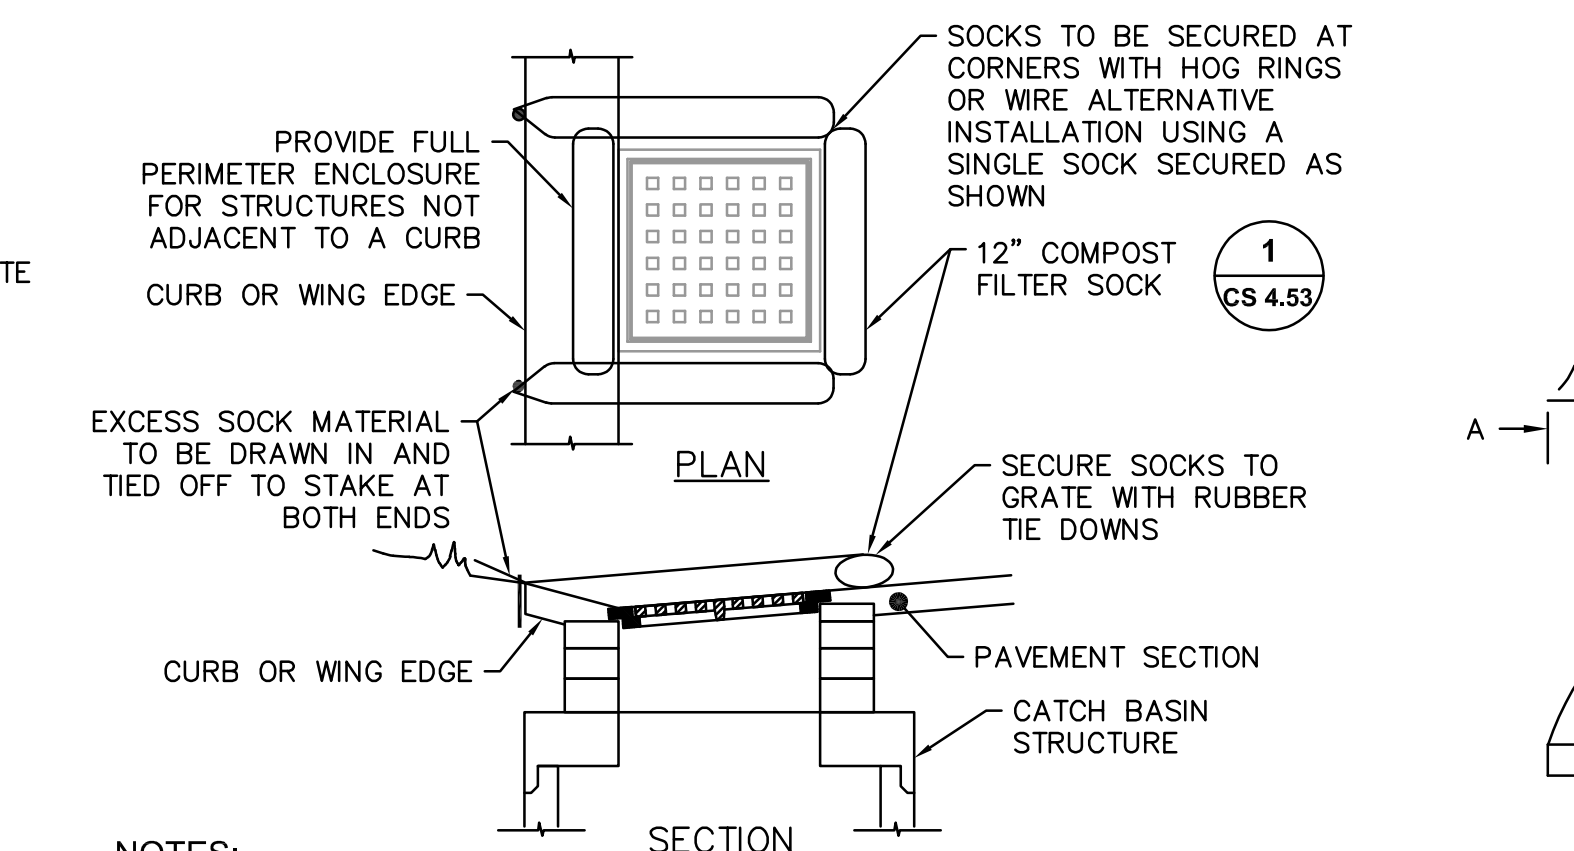

**NOTES:**  
 1. SECURE FILTERSOCK TO GROUND AT BOTH ENDS.  
 2. INLET TRENCH SHALL REMAIN IN-PLACE UNTIL SITE HAS BEEN STABILIZED.  
 3. SEE COMPOST FILTER SOCK INSTALLATION DETAIL FOR ADDITIONAL NOTES AND SPECIFICATIONS.

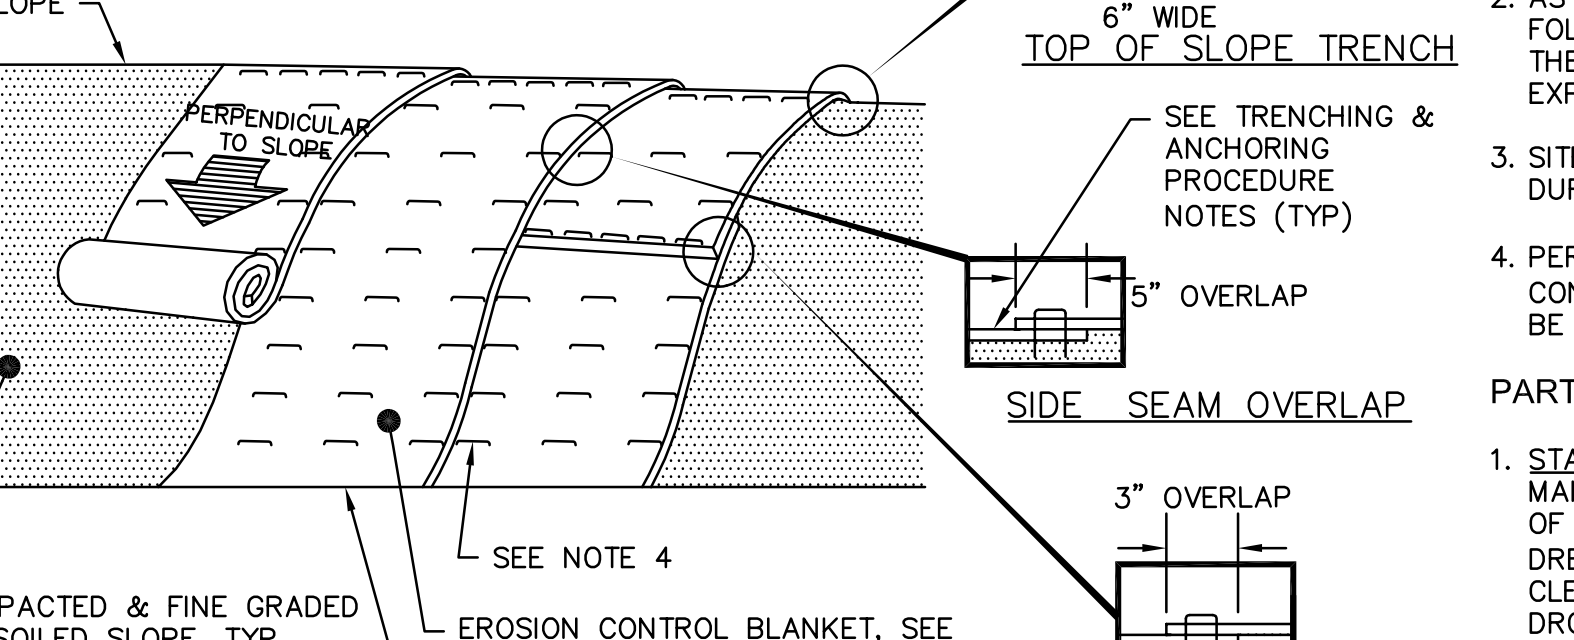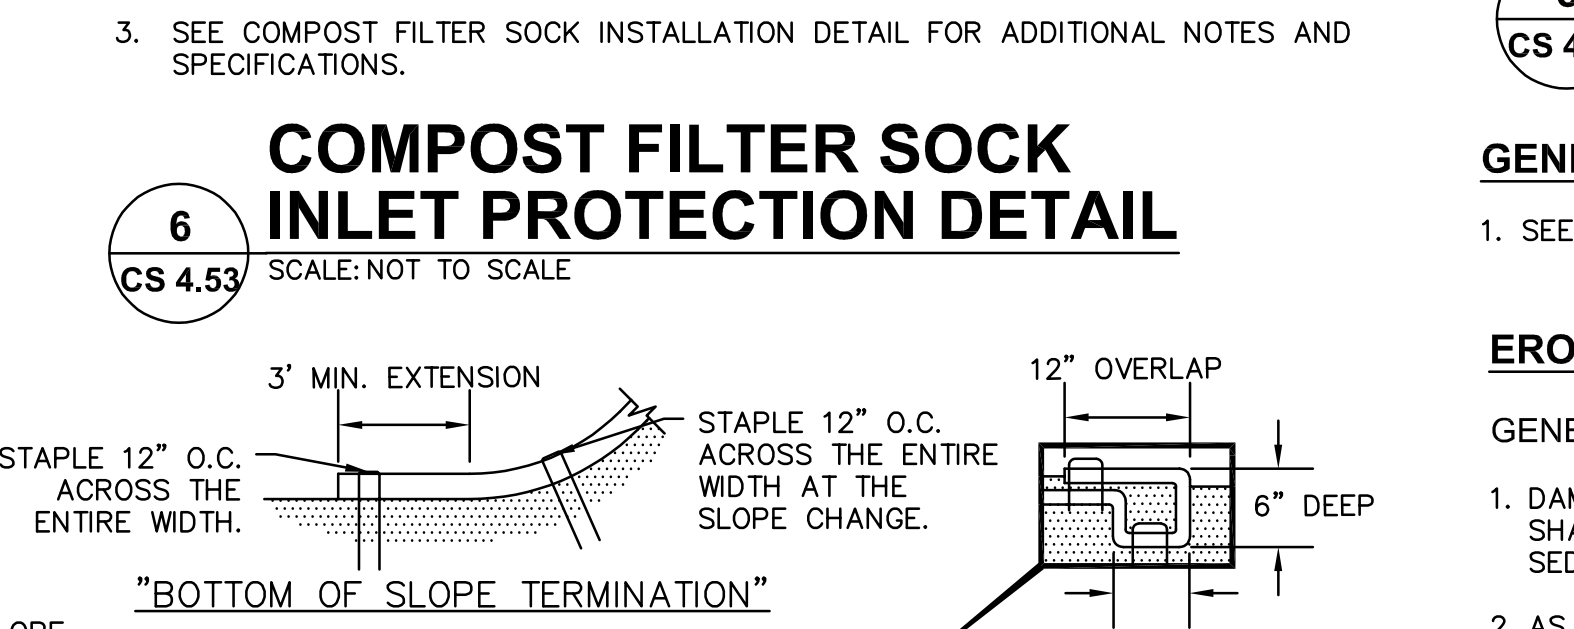


**NOTES:**  
 1. PREPARE THE TOPSOIL (SEEDBED) FIRST BY RAKING, SHAPING, FINE GRADING, COMPACTING, SEEDING & FERTILIZING THE SLOPES.  
 2. USE THE TRENCHING & ANCHORING PROCEDURES DETAILED HEREIN TO SECURE ANY EXPOSED MATERIAL ENDS. SECURE ALL PRODUCT OVERLAPS. OVERLAP IN THE DIRECTION OF WATER FLOW, PERPENDICULAR TO THE SLOPE.  
 3. KEEP EROSION CONTROL BLANKET IN SOLID CONTACT WITH THE TOPSOIL.  
 4. USE THE REQUIRED NUMBER OF STAPLES/STAKES TO SECURELY FASTEN THE EROSION CONTROL BLANKET TO THE SLOPE. IN LOOSE SOIL CONDITION, THE USE OF STAPLES/STAKES LENGTHS GREATER THAN 6" MAYBE NECESSARY FOR PROPER SECURING. STAPLE PATTERNS & OVERLAPS ARE DEPENDENT ON SITE CONDITIONS & MANUFACTURER'S REQUIREMENTS. CONTRACTOR SHALL CONSULT WITH MANUFACTURER FOR ACTUAL SITE SPECIFIC REQUIREMENTS.

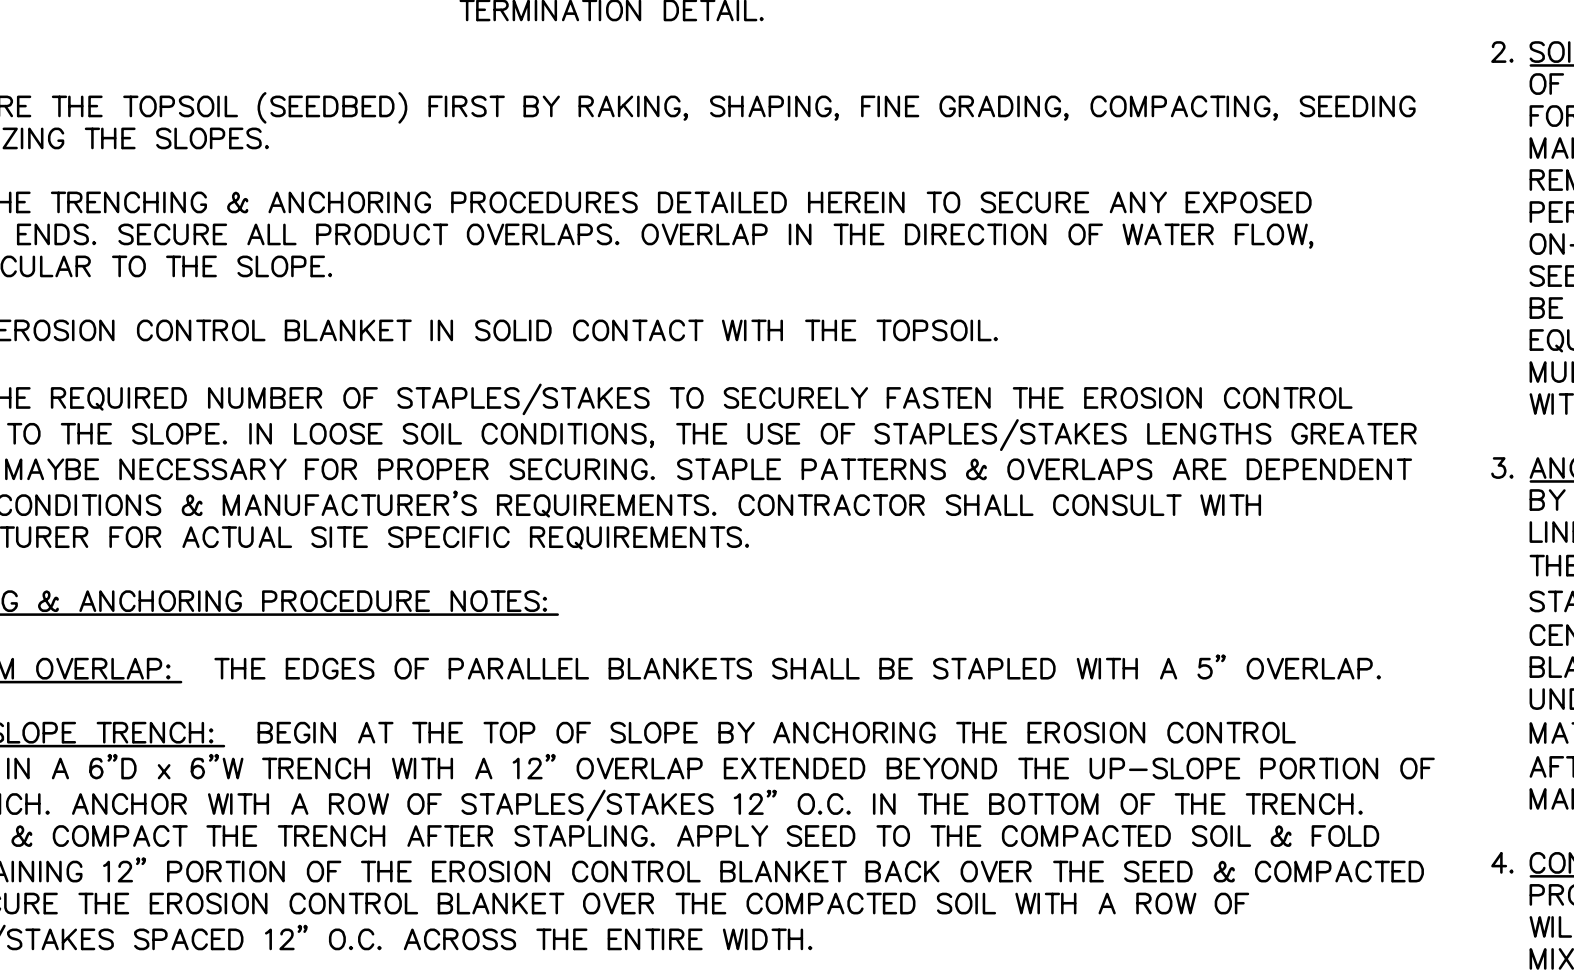


### 8 COMPOST FILTER SOCK INLET PROTECTION DETAIL

CS 4.53 SCALE: NOT TO SCALE

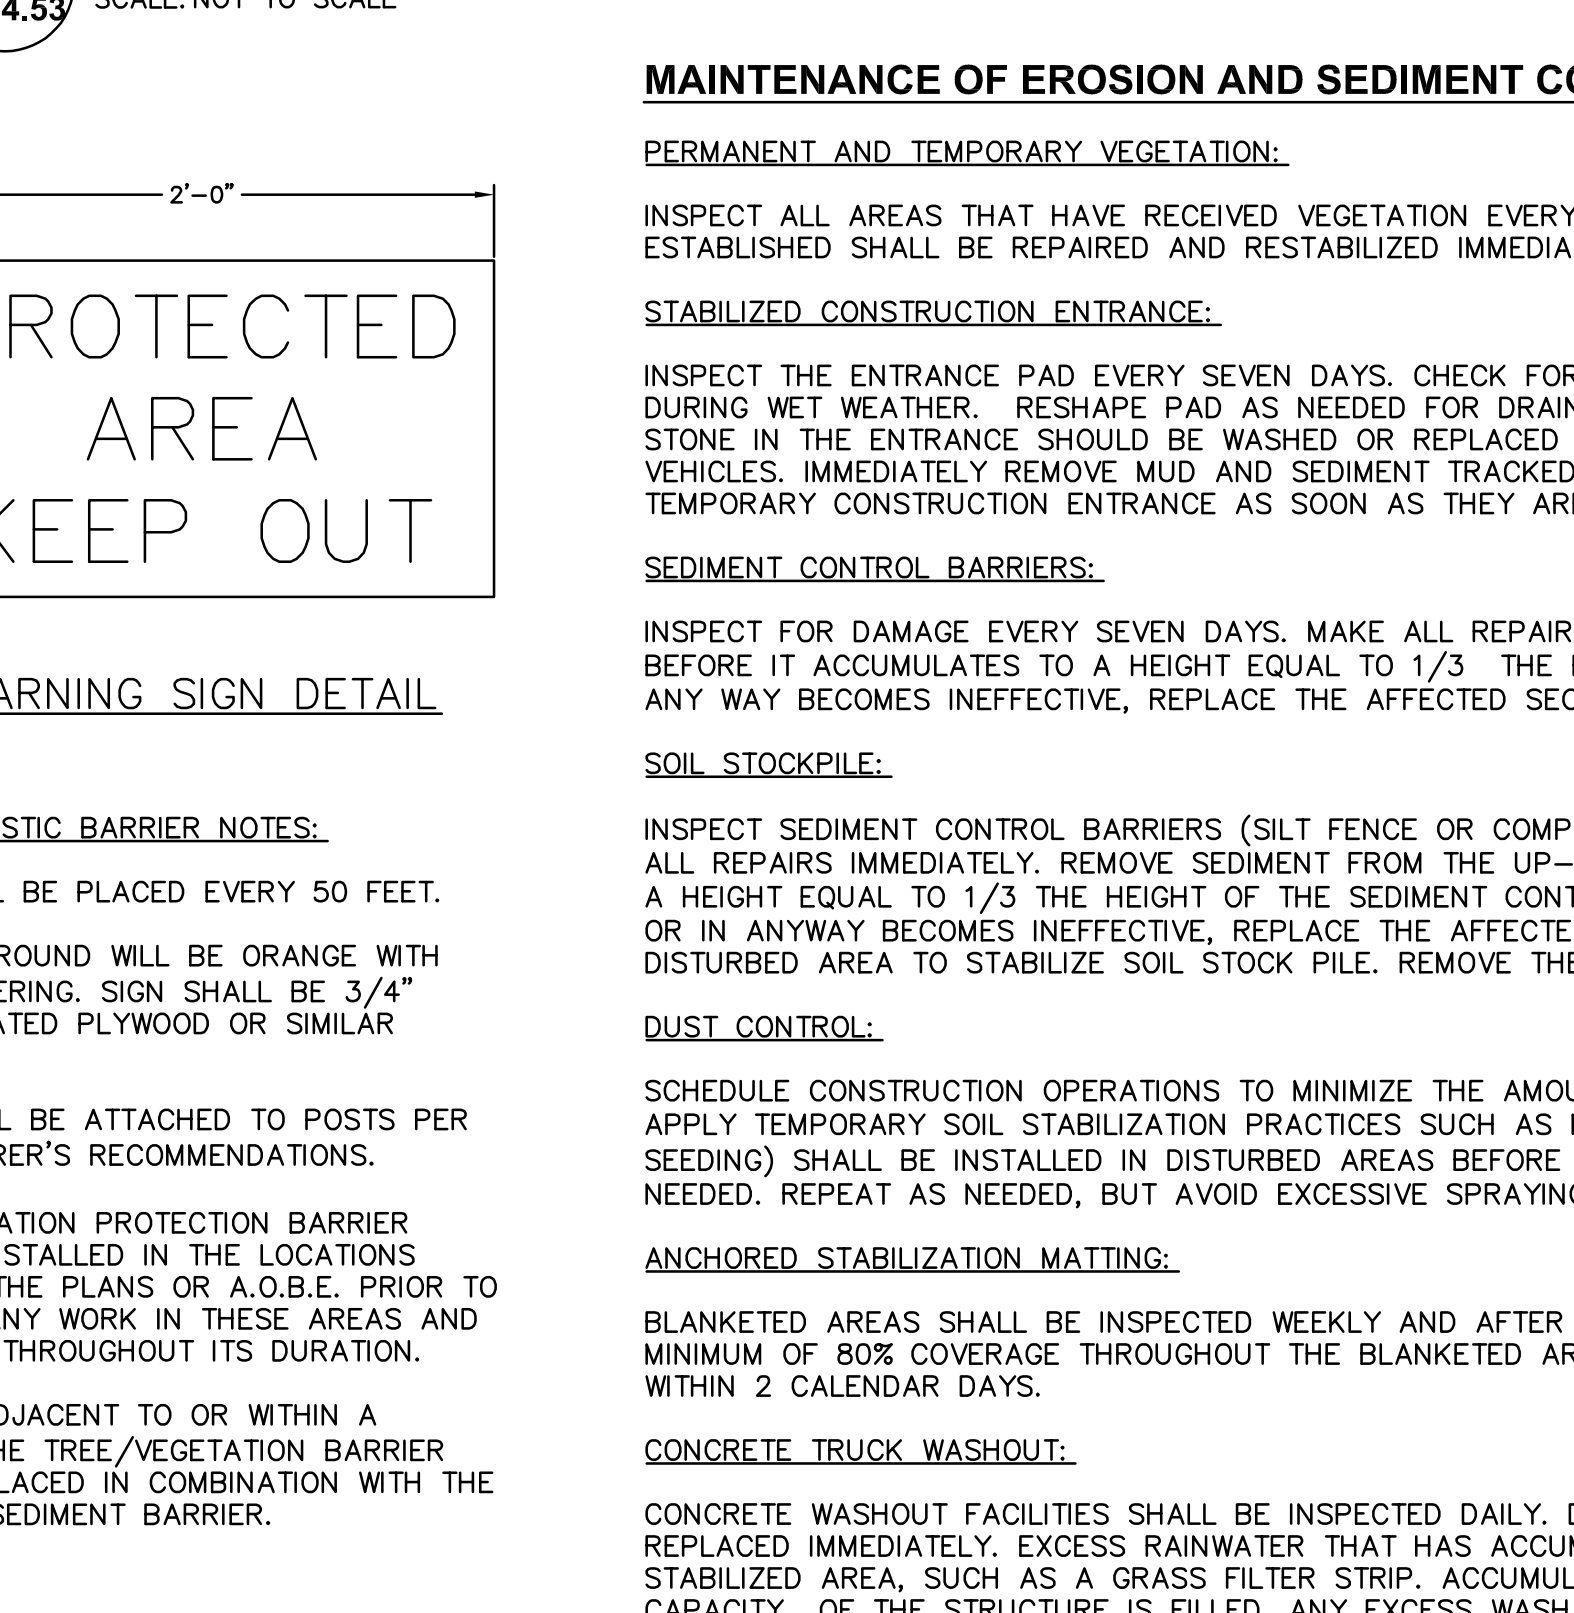

### 6 COMPOST FILTER SOCK INLET PROTECTION DETAIL



CS 4.53 SCALE: NOT TO SCALE

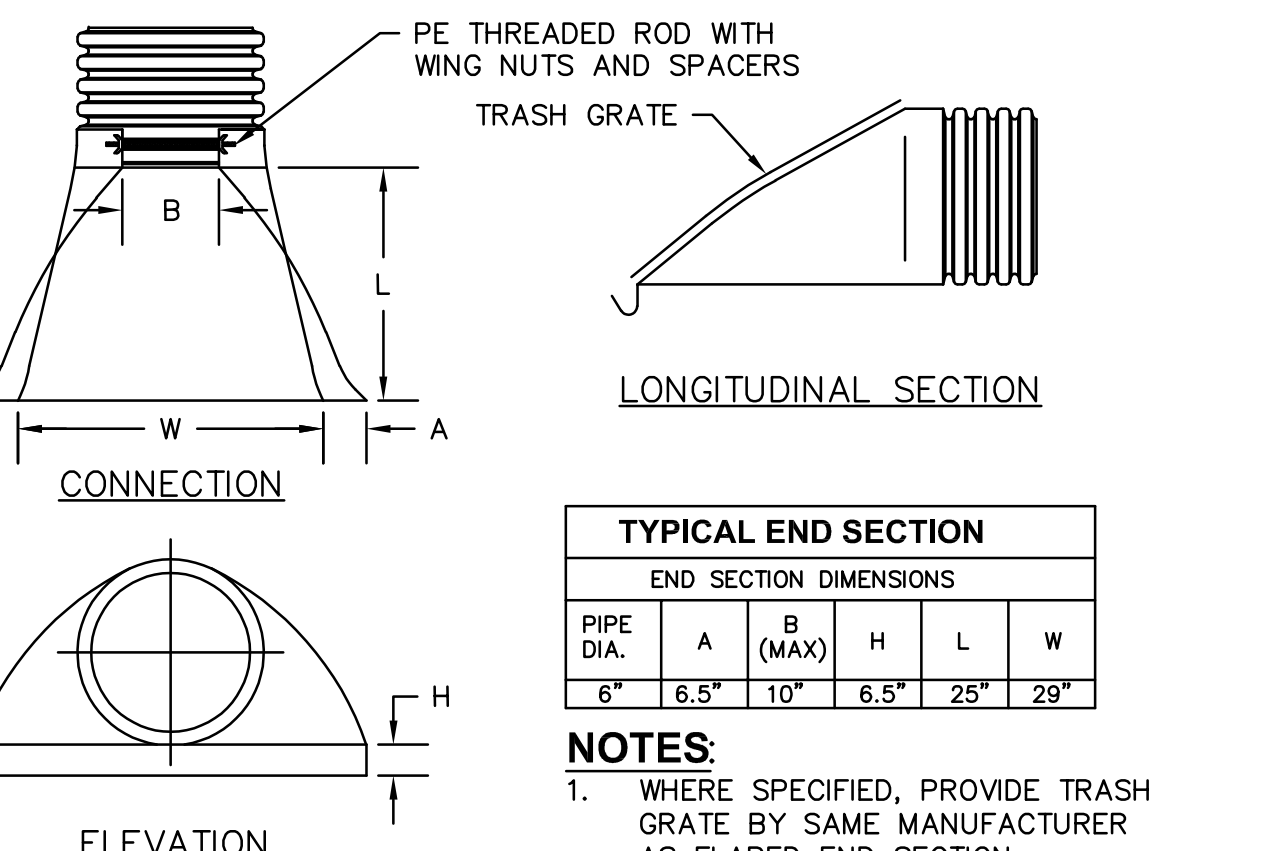


**GENERAL EROSION AND SEDIMENT CONTROL NOTES:**  
 1. SEE SHEET CS-51 FOR GENERAL EROSION AND SEDIMENT CONTROL NOTES.  
**EROSION AND SEDIMENT CONTROL MEASURES:**  
 GENERAL MEASURES:  
 1. DAMAGE TO SURFACE WATERS RESULTING FROM EROSION AND SEDIMENTATION SHALL BE MINIMIZED BY STABILIZING DISTURBED AREAS AND BY REMOVING SEDIMENT FROM CONSTRUCTION SITE DISCHARGES.  
 2. AS MUCH AS IS PRACTICAL, EXISTING VEGETATION SHALL BE PRESERVED. FOLLOWING THE COMPLETION OF CONSTRUCTION ACTIVITIES IN ANY PORTION OF THE SITE, PERMANENT VEGETATION SHALL BE ESTABLISHED ON ALL EXPOSED SOILS.  
 3. SITE PREPARATION ACTIVITIES SHALL BE PLANNED TO MINIMIZE THE SCOPE AND DURATION OF SOIL DISRUPTION.  
 4. PERMANENT TRAFFIC CORRIDORS SHALL BE ESTABLISHED AND "ROUTES OF CONVENIENCE" SHALL BE AVOIDED. STABILIZED CONSTRUCTION ENTRANCES SHALL BE INSTALLED AT ALL POINTS OF ENTRY ONTO THE PROJECT SITE.  
 PARTICULAR MEASURES:  
 1. STABILIZED CONSTRUCTION ENTRANCE, UTILIZED DURING CONSTRUCTION, SHALL BE MAINTAINED IN A CONDITION THAT SHALL PREVENT TRACKING OR FLOWING OF SEDIMENT ONTO PUBLIC RIGHTS-OF-WAY. THIS MAY REQUIRE PERIODIC TOP DRESSING WITH ADDITIONAL STONE AS CONDITIONS DEMAND AND REPAIR AND/OR CLEANOUT OF ANY MEASURES USED TO TRAP SEDIMENT. ALL SEDIMENT SPILLED, DROPPED, WASHED OR TRACKED ONTO PUBLIC RIGHTS-OF-WAY MUST BE REMOVED IMMEDIATELY. WHEELS SHALL BE CLEANED TO REMOVE SEDIMENT PRIOR TO ENTRANCE ONTO PUBLIC RIGHTS-OF-WAY. WHEN WASHING IS REQUIRED, IT SHALL BE DONE ON AN AREA STABILIZED WITH STONE AND WHICH DRAINS INTO AN APPROVED SEDIMENT TRAPPING DEVICE. PERIODIC INSPECTIONS AND NEEDED MAINTENANCE SHALL BE PROVIDED AFTER EACH RAIN.  
 2. SOIL STOCKPILES: SILT FENCES SHALL BE CONSTRUCTED AROUND ALL STOCKPILES OF FILL TOPSOIL, AND EXCAVATED OVERBURDEN THAT ARE TO REMAIN EXPOSED FOR PERIODS LESS THAN 21 DAYS. SILT FENCES SHALL BE ANCHORED AND MAINTAINED IN GOOD CONDITION UNTIL SUCH TIME AS SAID STOCKPILES ARE REMOVED AND STOCKPILING AREAS ARE BROUGHT TO FINAL GRADE AND PERMANENTLY STABILIZED. TOPSOIL AND FILL THAT IS TO REMAIN STOCKPILED ON-SITE FOR PERIODS GREATER THAN 21 DAYS SHALL BE STABILIZED BY SEEDING. PRIOR TO THE SEEDING OPERATION, THE STOCKPILED MATERIAL SHALL BE GRADED AS NEEDED AND FEASIBLE TO PERMIT THE USE OF CONVENTIONAL EQUIPMENT FOR SEEDBED PREPARATION, SEEDING, MULCH APPLICATION, AND MULCH ANCHORING. IN NO CASE SHALL ERODIBLE MATERIALS BE STOCKPILED WITHIN 25 FEET OF ANY DITCH, STREAM, OR OTHER SURFACE WATER BODY.  
 3. ANCHORED STABILIZATION MATTING: PREPARE SOIL BEFORE INSTALLING MATTING BY SMOOTHING SURFACE, REMOVING DEBRIS AND LARGE STONE, AND APPLYING LINE, FERTILIZER AND SEED. BEGIN AT THE TOP OF THE SLOPE BY ANCHORING THE MAT IN A 6" DEEP BY 6" WIDE TRENCH, BACKFILL AND COMPACT AFTER STAPLING. ROLL MATS DOWN THE SLOPE WITH A MINIMUM 4" OVERLAP. ROLL CENTER MAT IN A CHANNEL IN THE DIRECTION OF WATER FLOW. DO NOT STRETCH BLANKETS. BLANKETS SHALL HAVE GOOD CONTINUOUS CONTACT WITH THE UNDERLYING SOIL THROUGHOUT ITS ENTIRE LENGTH. THE TERMINAL END OF THE MATS MUST BE ANCHORED IN A 6" x 6" WIDE TRENCH, BACKFILL AND COMPACT AFTER STAPLING. STAPLING SHALL BE DONE IN ACCORDANCE WITH MANUFACTURER'S SPECIFICATIONS.  
 4. CONCRETE TRUCK WASHOUT: WASHOUT FACILITIES SHALL BE PROVIDED FOR EVERY PROJECT WHERE CONCRETE WILL BE POURED OR FORMED ON SITE. THIS FACILITY WILL RECEIVE HIGHLY ALKALINE WASH WATER FROM THE CLEANING OF CHUTES, MIXERS, HOPPERS, VIBRATORS, PLACING EQUIPMENT, TROWELS AND SPODES. THE FACILITY MUST BE LOCATED A MINIMUM OF 100 FEET FROM DRAINAGE SWALES, STORM DRAIN INLETS, WETLANDS, STREAMS, AND OTHER SURFACE WATERS. ALL WASHOUT FACILITIES WILL BE LEANED TO PREVENT LEACHING OF LIQUIDS INTO THE GROUND. THE LINER SHALL BE PLASTIC SHEETING WITH A MINIMUM THICKNESS OF 10 MILS WITH NO HOLES OR TEARS AND ANCHORED BEYOND THE TOP OF THE PIT WITH AND EARTHEN BERM, SAND BAGS, STONE, OR OTHER STRUCTURAL APPURTENANCE EXCEPT AT THE ACCESS POINT.

### 8 TYPICAL FLARED END SECTION

CS 4.53 SCALE: NOT TO SCALE

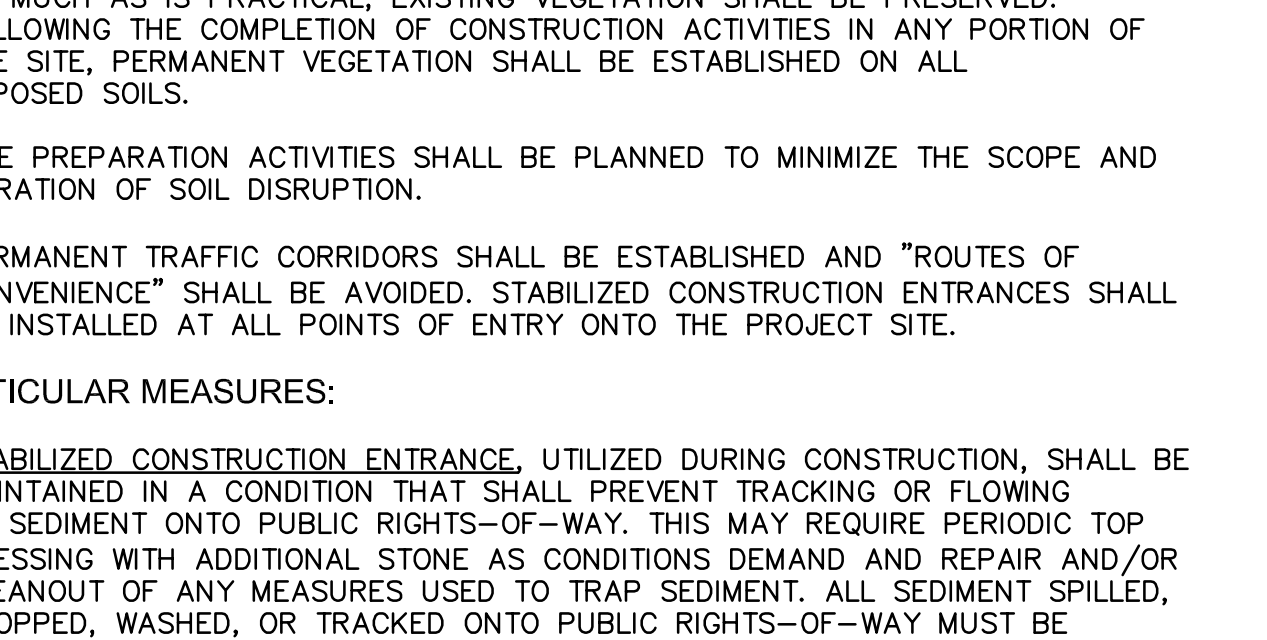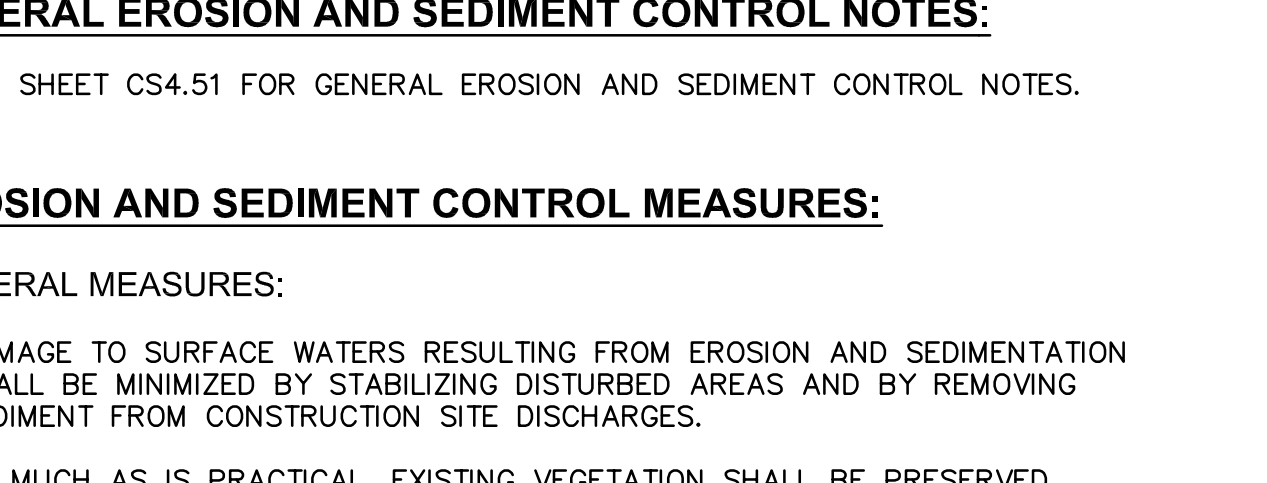


**GENERAL MEASURES:**  
 1. DAMAGE TO SURFACE WATERS RESULTING FROM EROSION AND SEDIMENTATION SHALL BE MINIMIZED BY STABILIZING DISTURBED AREAS AND BY REMOVING SEDIMENT FROM CONSTRUCTION SITE DISCHARGES.  
 2. AS MUCH AS IS PRACTICAL, EXISTING VEGETATION SHALL BE PRESERVED. FOLLOWING THE COMPLETION OF CONSTRUCTION ACTIVITIES IN ANY PORTION OF THE SITE, PERMANENT VEGETATION SHALL BE ESTABLISHED ON ALL EXPOSED SOILS.  
 3. SITE PREPARATION ACTIVITIES SHALL BE PLANNED TO MINIMIZE THE SCOPE AND DURATION OF SOIL DISRUPTION.  
 4. PERMANENT TRAFFIC CORRIDORS SHALL BE ESTABLISHED AND "ROUTES OF CONVENIENCE" SHALL BE AVOIDED. STABILIZED CONSTRUCTION ENTRANCES SHALL BE INSTALLED AT ALL POINTS OF ENTRY ONTO THE PROJECT SITE.  
 PARTICULAR MEASURES:  
 1. STABILIZED CONSTRUCTION ENTRANCE, UTILIZED DURING CONSTRUCTION, SHALL BE MAINTAINED IN A CONDITION THAT SHALL PREVENT TRACKING OR FLOWING OF SEDIMENT ONTO PUBLIC RIGHTS-OF-WAY. THIS MAY REQUIRE PERIODIC TOP DRESSING WITH ADDITIONAL STONE AS CONDITIONS DEMAND AND REPAIR AND/OR CLEANOUT OF ANY MEASURES USED TO TRAP SEDIMENT. ALL SEDIMENT SPILLED, DROPPED, WASHED OR TRACKED ONTO PUBLIC RIGHTS-OF-WAY MUST BE REMOVED IMMEDIATELY. WHEELS SHALL BE CLEANED TO REMOVE SEDIMENT PRIOR TO ENTRANCE ONTO PUBLIC RIGHTS-OF-WAY. WHEN WASHING IS REQUIRED, IT SHALL BE DONE ON AN AREA STABILIZED WITH STONE AND WHICH DRAINS INTO AN APPROVED SEDIMENT TRAPPING DEVICE. PERIODIC INSPECTIONS AND NEEDED MAINTENANCE SHALL BE PROVIDED AFTER EACH RAIN.  
 2. SOIL STOCKPILES: SILT FENCES SHALL BE CONSTRUCTED AROUND ALL STOCKPILES OF FILL TOPSOIL, AND EXCAVATED OVERBURDEN THAT ARE TO REMAIN EXPOSED FOR PERIODS LESS THAN 21 DAYS. SILT FENCES SHALL BE ANCHORED AND MAINTAINED IN GOOD CONDITION UNTIL SUCH TIME AS SAID STOCKPILES ARE REMOVED AND STOCKPILING AREAS ARE BROUGHT TO FINAL GRADE AND PERMANENTLY STABILIZED. TOPSOIL AND FILL THAT IS TO REMAIN STOCKPILED ON-SITE FOR PERIODS GREATER THAN 21 DAYS SHALL BE STABILIZED BY SEEDING. PRIOR TO THE SEEDING OPERATION, THE STOCKPILED MATERIAL SHALL BE GRADED AS NEEDED AND FEASIBLE TO PERMIT THE USE OF CONVENTIONAL EQUIPMENT FOR SEEDBED PREPARATION, SEEDING, MULCH APPLICATION, AND MULCH ANCHORING. IN NO CASE SHALL ERODIBLE MATERIALS BE STOCKPILED WITHIN 25 FEET OF ANY DITCH, STREAM, OR OTHER SURFACE WATER BODY.  
 3. ANCHORED STABILIZATION MATTING: PREPARE SOIL BEFORE INSTALLING MATTING BY SMOOTHING SURFACE, REMOVING DEBRIS AND LARGE STONE, AND APPLYING LINE, FERTILIZER AND SEED. BEGIN AT THE TOP OF THE SLOPE BY ANCHORING THE MAT IN A 6" DEEP BY 6" WIDE TRENCH, BACKFILL AND COMPACT AFTER STAPLING. ROLL MATS DOWN THE SLOPE WITH A MINIMUM 4" OVERLAP. ROLL CENTER MAT IN A CHANNEL IN THE DIRECTION OF WATER FLOW. DO NOT STRETCH BLANKETS. BLANKETS SHALL HAVE GOOD CONTINUOUS CONTACT WITH THE UNDERLYING SOIL THROUGHOUT ITS ENTIRE LENGTH. THE TERMINAL END OF THE MATS MUST BE ANCHORED IN A 6" x 6" WIDE TRENCH, BACKFILL AND COMPACT AFTER STAPLING. STAPLING SHALL BE DONE IN ACCORDANCE WITH MANUFACTURER'S SPECIFICATIONS.  
 4. CONCRETE TRUCK WASHOUT: WASHOUT FACILITIES SHALL BE PROVIDED FOR EVERY PROJECT WHERE CONCRETE WILL BE POURED OR FORMED ON SITE. THIS FACILITY WILL RECEIVE HIGHLY ALKALINE WASH WATER FROM THE CLEANING OF CHUTES, MIXERS, HOPPERS, VIBRATORS, PLACING EQUIPMENT, TROWELS AND SPODES. THE FACILITY MUST BE LOCATED A MINIMUM OF 100 FEET FROM DRAINAGE SWALES, STORM DRAIN INLETS, WETLANDS, STREAMS, AND OTHER SURFACE WATERS. ALL WASHOUT FACILITIES WILL BE LEANED TO PREVENT LEACHING OF LIQUIDS INTO THE GROUND. THE LINER SHALL BE PLASTIC SHEETING WITH A MINIMUM THICKNESS OF 10 MILS WITH NO HOLES OR TEARS AND ANCHORED BEYOND THE TOP OF THE PIT WITH AND EARTHEN BERM, SAND BAGS, STONE, OR OTHER STRUCTURAL APPURTENANCE EXCEPT AT THE ACCESS POINT.

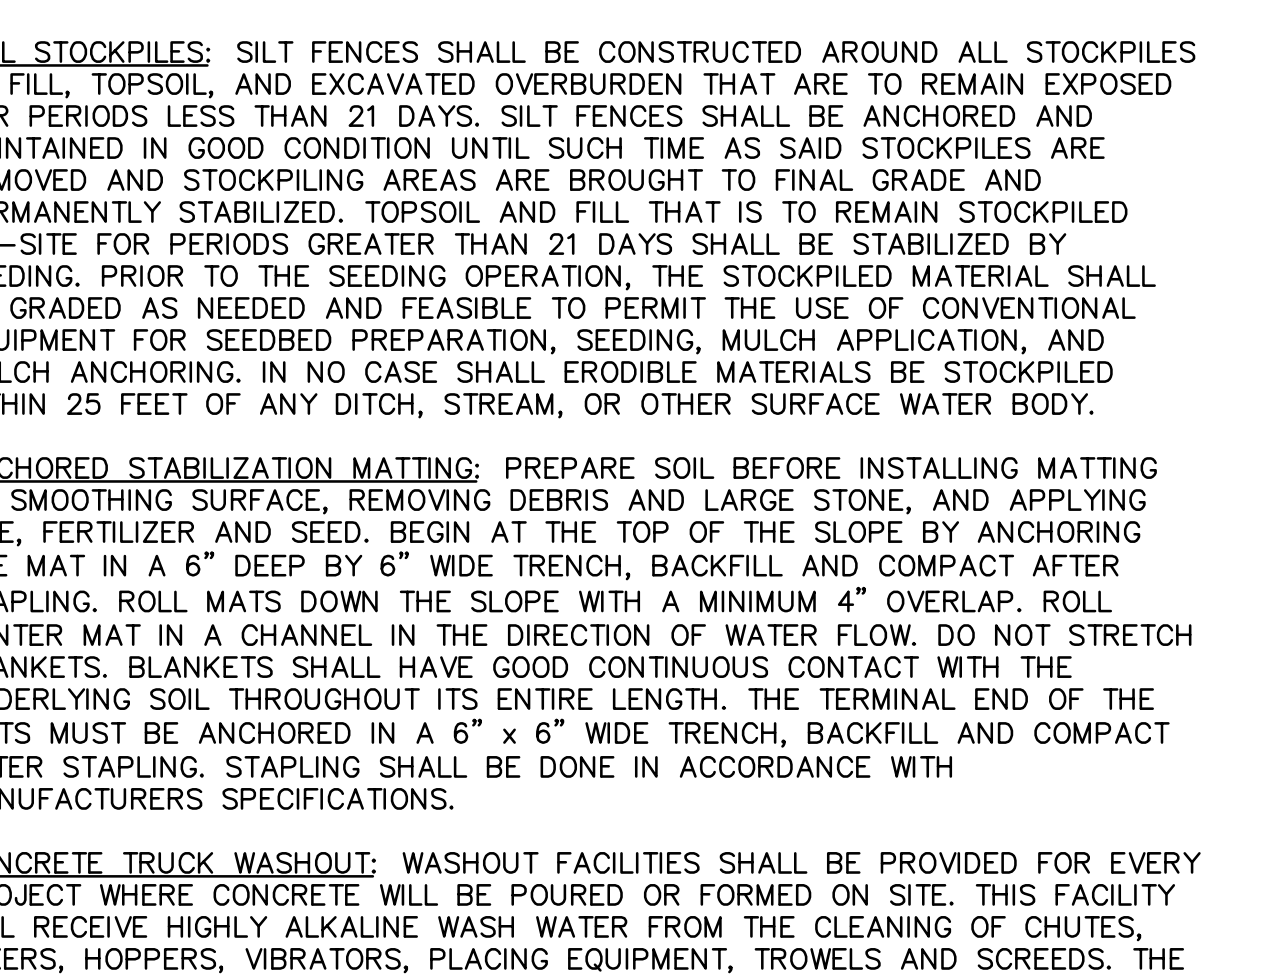

### 8 TYPICAL FLARED END SECTION

CS 4.53 SCALE: NOT TO SCALE

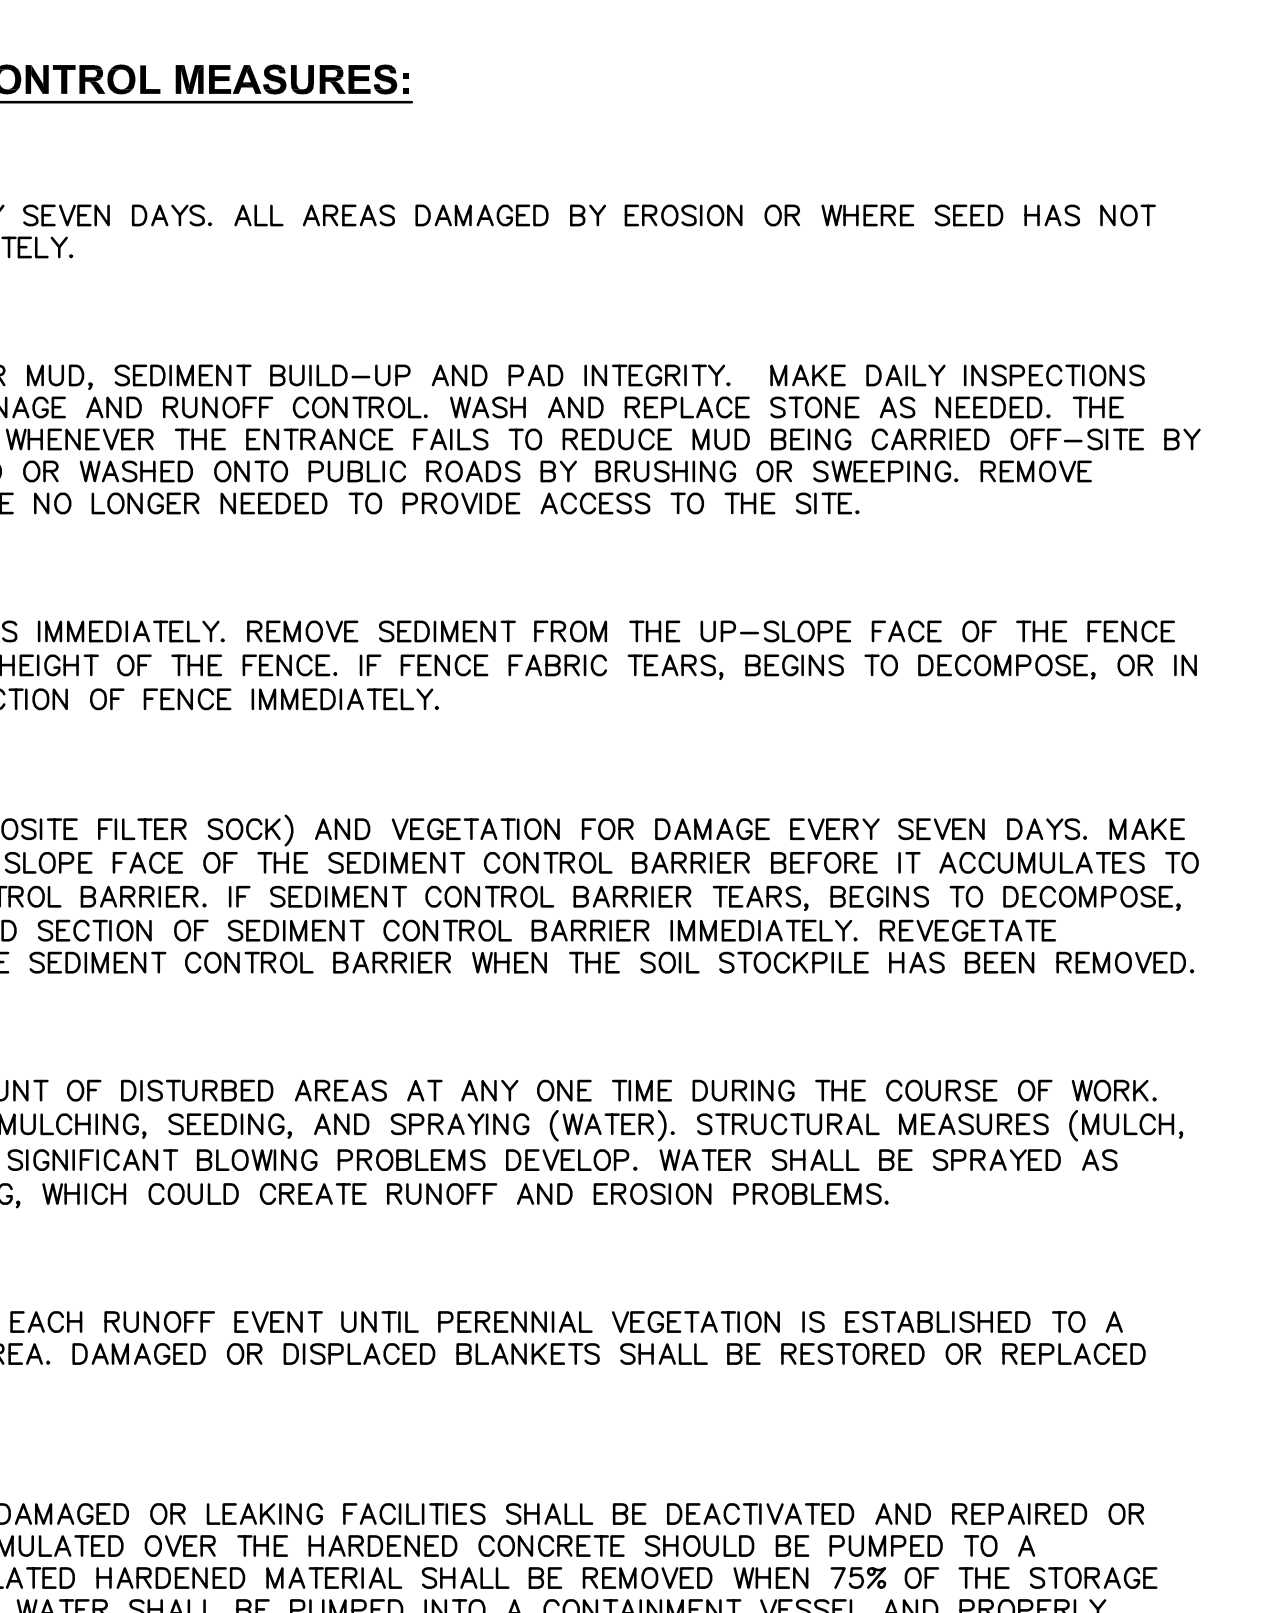

### 8 TYPICAL FLARED END SECTION

CS 4.53 SCALE: NOT TO SCALE

REV	DATE	ITEM

**NOTICE:**  
 THESE DRAWINGS ARE BASED ON CONSTRUCTION DRAWINGS NOT PREPARED BY THE ARCHITECTS. LANDSCAPE ARCHITECTS AND ENGINEERS, P.C. HAS CONDUCTED VISUAL VERIFICATION OF THE EXISTING CONDITIONS AS SHOWN ON THE DRAWINGS. ALL EXISTING CONDITIONS SHOWN ARE REPRESENTED AS SUCCINCT INFORMATION AS THEY MAY NOT HAVE BEEN FULLY AND DETAILED FOR THE ORIGINAL DOCUMENTS OR THE CONSTRUCTION RECORD.

**GPI** Engineering Design Construction Inspection  
 518.453.9421 GIPNET.COM  
 Greenman-Pedersen, Inc.  
 80 Wolf Road, Suite 600  
 Albany, NY 12205

**PC**  
 STATE UNIVERSITY OF NEW YORK  
 PURCHASE COLLEGE  
 735 ANDERSON HILL ROAD, PURCHASE, NEW YORK 10577

**BBS**  
 ARCHITECTS  
 LANDSCAPE ARCHITECTS  
 ENGINEERS  
 244 EAST MAIN STREET ALBANY, NY 12202  
 187 WOLF ROAD, STE. 205 ALBANY, NY 12205  
 NEW YORK 11772 NEW YORK 12050  
 T: 518.475.0349 T: 518.621.7650  
 F: 518.475.0349 F: 518.621.7650  
 www.BBSARCHITECTURE.com

**STATE OF NEW YORK**  
 ARCHITECTS AND ENGINEERS  
 093753  
 PROFESSIONAL ENGINEER

CONTRACT NO. SU-98203 - GENERAL CONST.  
 SU-98203 - ELECTRICAL  
 CLIENT: SUNY PURCHASE COLLEGE  
 PROJECT: MULTIPURPOSE SYNTHETIC TURF FACILITY  
 DWG TITLE: STORMWATER DETAILS

SCALE: AS SHOWN  
 DATE: OCTOBER 25, 2023  
 BID PICK-UP:  
 FILE NO: 23-158

### CS4.53



REV.	DATE	ITEM

**NOTICE**  
 THESE DRAWINGS ARE BASED ON CONSTRUCTION DRAWINGS NOT PREPARED BY BBS ARCHITECTS, LANDSCAPE ARCHITECTS AND ENGINEERS, P.C. AND THEREFORE MAY NOT REPRESENT THE CONDITIONS AS CONSTRUCTED AT THE TIME. ALL EXISTING CONDITIONS SHOWN ARE REPRESENTED AS SUGGESTIVE INFORMATION AS THEY MAY NOT HAVE BEEN REVEALED AND OBTAINED FROM THE ORIGINAL DOCUMENTS OR FROM THE OWNER'S INFORMATION.



**KEY PLAN**  
 NOT TO SCALE


**PROJECT**  
 MULTI-PURPOSE SYNTHETIC TURF FACILITY  
 PURCHASE COLLEGE  
 STATE UNIVERSITY OF NEW YORK  
 735 ANDERSON HILL ROAD, PURCHASE, NEW YORK 10577

**DWG TITLE**  
 SITE DETAILS

**DRAWING BY:** JRL  
**CHECK BY:** JRL

**NOTICE**  
 THIS DRAWING, PREPARED FOR THE SPECIFIC PROJECT INDICATED IS AN INSTRUMENT OF SERVICE AND THE PROPERTY OF BBS ARCHITECTS, LANDSCAPE ARCHITECTS AND ENGINEERS, P.C. INFRACTION OR ANY USE OF THE DRAWING FOR ANY OTHER PROJECT IS PROHIBITED. ANY ALTERATION OR REPRODUCTION OF THIS DOCUMENT IS ALSO PROHIBITED WITHOUT THE WRITTEN CONSENT OF THE ARCHITECT OR ENGINEER.

**BBS ARCHITECTS**  
 LANDSCAPE ARCHITECTS  
 ENGINEERS  
 244 EAST MAIN STREET | 187 WOLF ROAD, STE. 205  
 PATCHOGUE | ALBANY  
 NEW YORK 11772 | NEW YORK 12205  
 T. 516.431.0349 | T. 518.621.7650  
 F. 516.431.0361 | F. 518.621.7655  
 www.bbsarchitecture.com

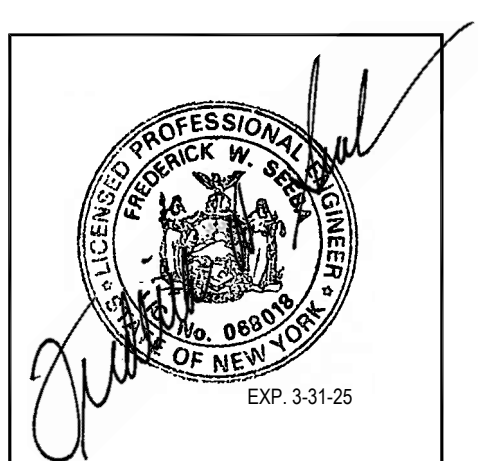


**CONTRACT No.:** SU-022823 - GENERAL CONST.  
 SU-022923 - ELECTRICAL  
**CLIENT:** SUNY PURCHASE COLLEGE  
**PROJECT:** MULTI-PURPOSE SYNTHETIC TURF FACILITY  
**DWG TITLE:** SITE DETAILS AND DEMOLITION PLAN  
**SCALE:** AS NOTED  
**DATE:** OCTOBER 25, 2023  
**BID PICK-UP:**  
**FILE No.:** 23-158

**CS6.02**

**SCOREBOARD GENERAL NOTES:**


1. CONCRETE TO BE 4500 PSI @ 28 DAYS.
2. REINFORCING STEEL, GRADE 60, SHALL CONFORM TO ASTM A615
3. COLUMN STEEL GRADE: A992 (50 KSI STEEL MIN.)
4. MINIMUM BOLT GRADE: A307
5. POLES TO BE TEMPORARILY SUPPORTED DURING CONCRETE PLACEMENT AND SUPPORTED UNTIL SCOREBOARDS ARE INSTALLED.
6. FOOTING AND DIMENSIONS ARE MINIMUM. ALL FINAL DIMENSIONS SHALL BE COORDINATED WITH THE MANUFACTURER ENGINEER'S REQUIREMENTS.
7. SUPPORT POST DESIGN CRITERIA: WIND EXPOSURE C, DESIGN WIND, 103 MPH, ULTIMATE 130 MPH.
8. VERIFY ALL DIMENSIONS WITH MANUFACTURER'S DRAWINGS.
9. STRUCTURAL STEEL TO CONFORM TO ASTM A-572, F<sub>y</sub> = 50 KSI AND SHALL BE FABRICATED TO THE LATEST EDITION OF THE AISC STEEL CONSTRUCTION MANUAL.
10. FIELD BOLT CONNECTIONS TO BE ASTM A325 HIGH STRENGTH BOLTS.
11. FOOTINGS INSTALLED IN GROUNDWATER SHALL BE DEWATERED DURING CONCRETE PLACEMENT OPERATIONS. CONCRETE BACKFILL MUST BE PLACED WITH A TREMIE METHOD WHEN SLURRY OR WATER IS PRESENT WITHIN THE EXCAVATION AND WHEN THE FREE DROP EXCEEDS 6'-0".

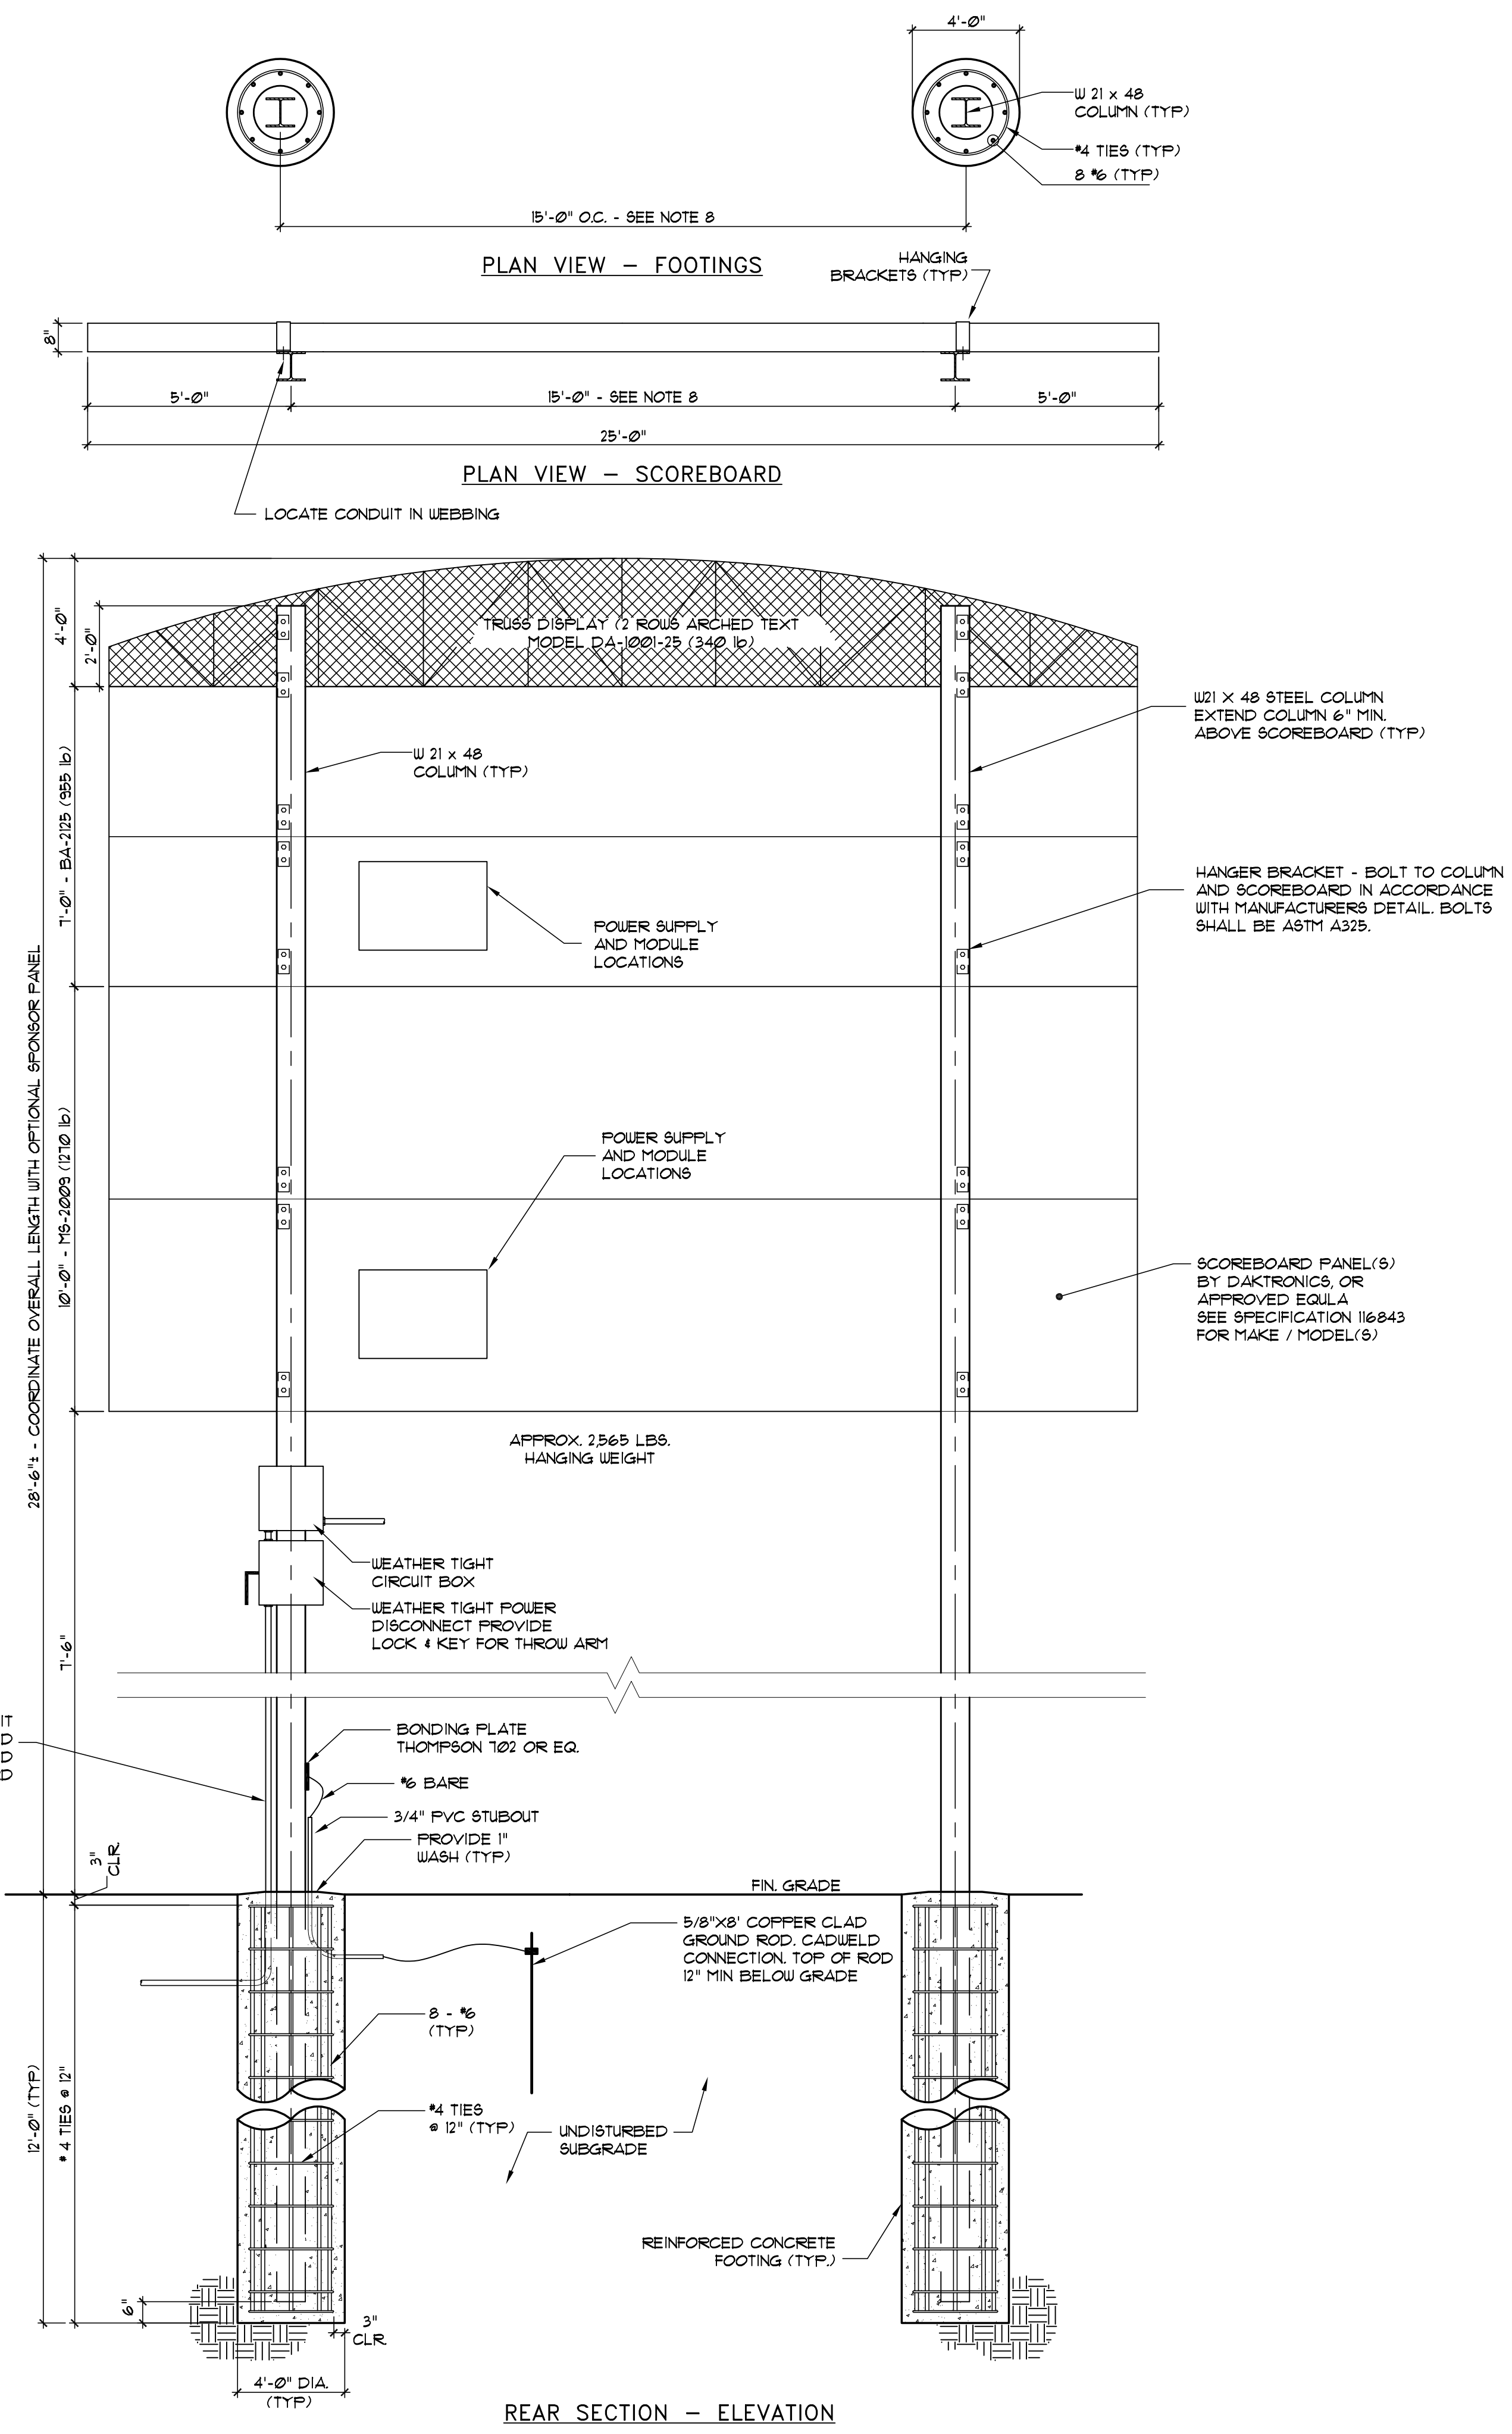

**1 SCOREBOARD DETAIL**

NOTE: FOOTING AND SUPPORT POST INSTALLATION IS BY THE GC. ALL OTHER WORK IS BY THE EC.


SCALE: N.T.S.

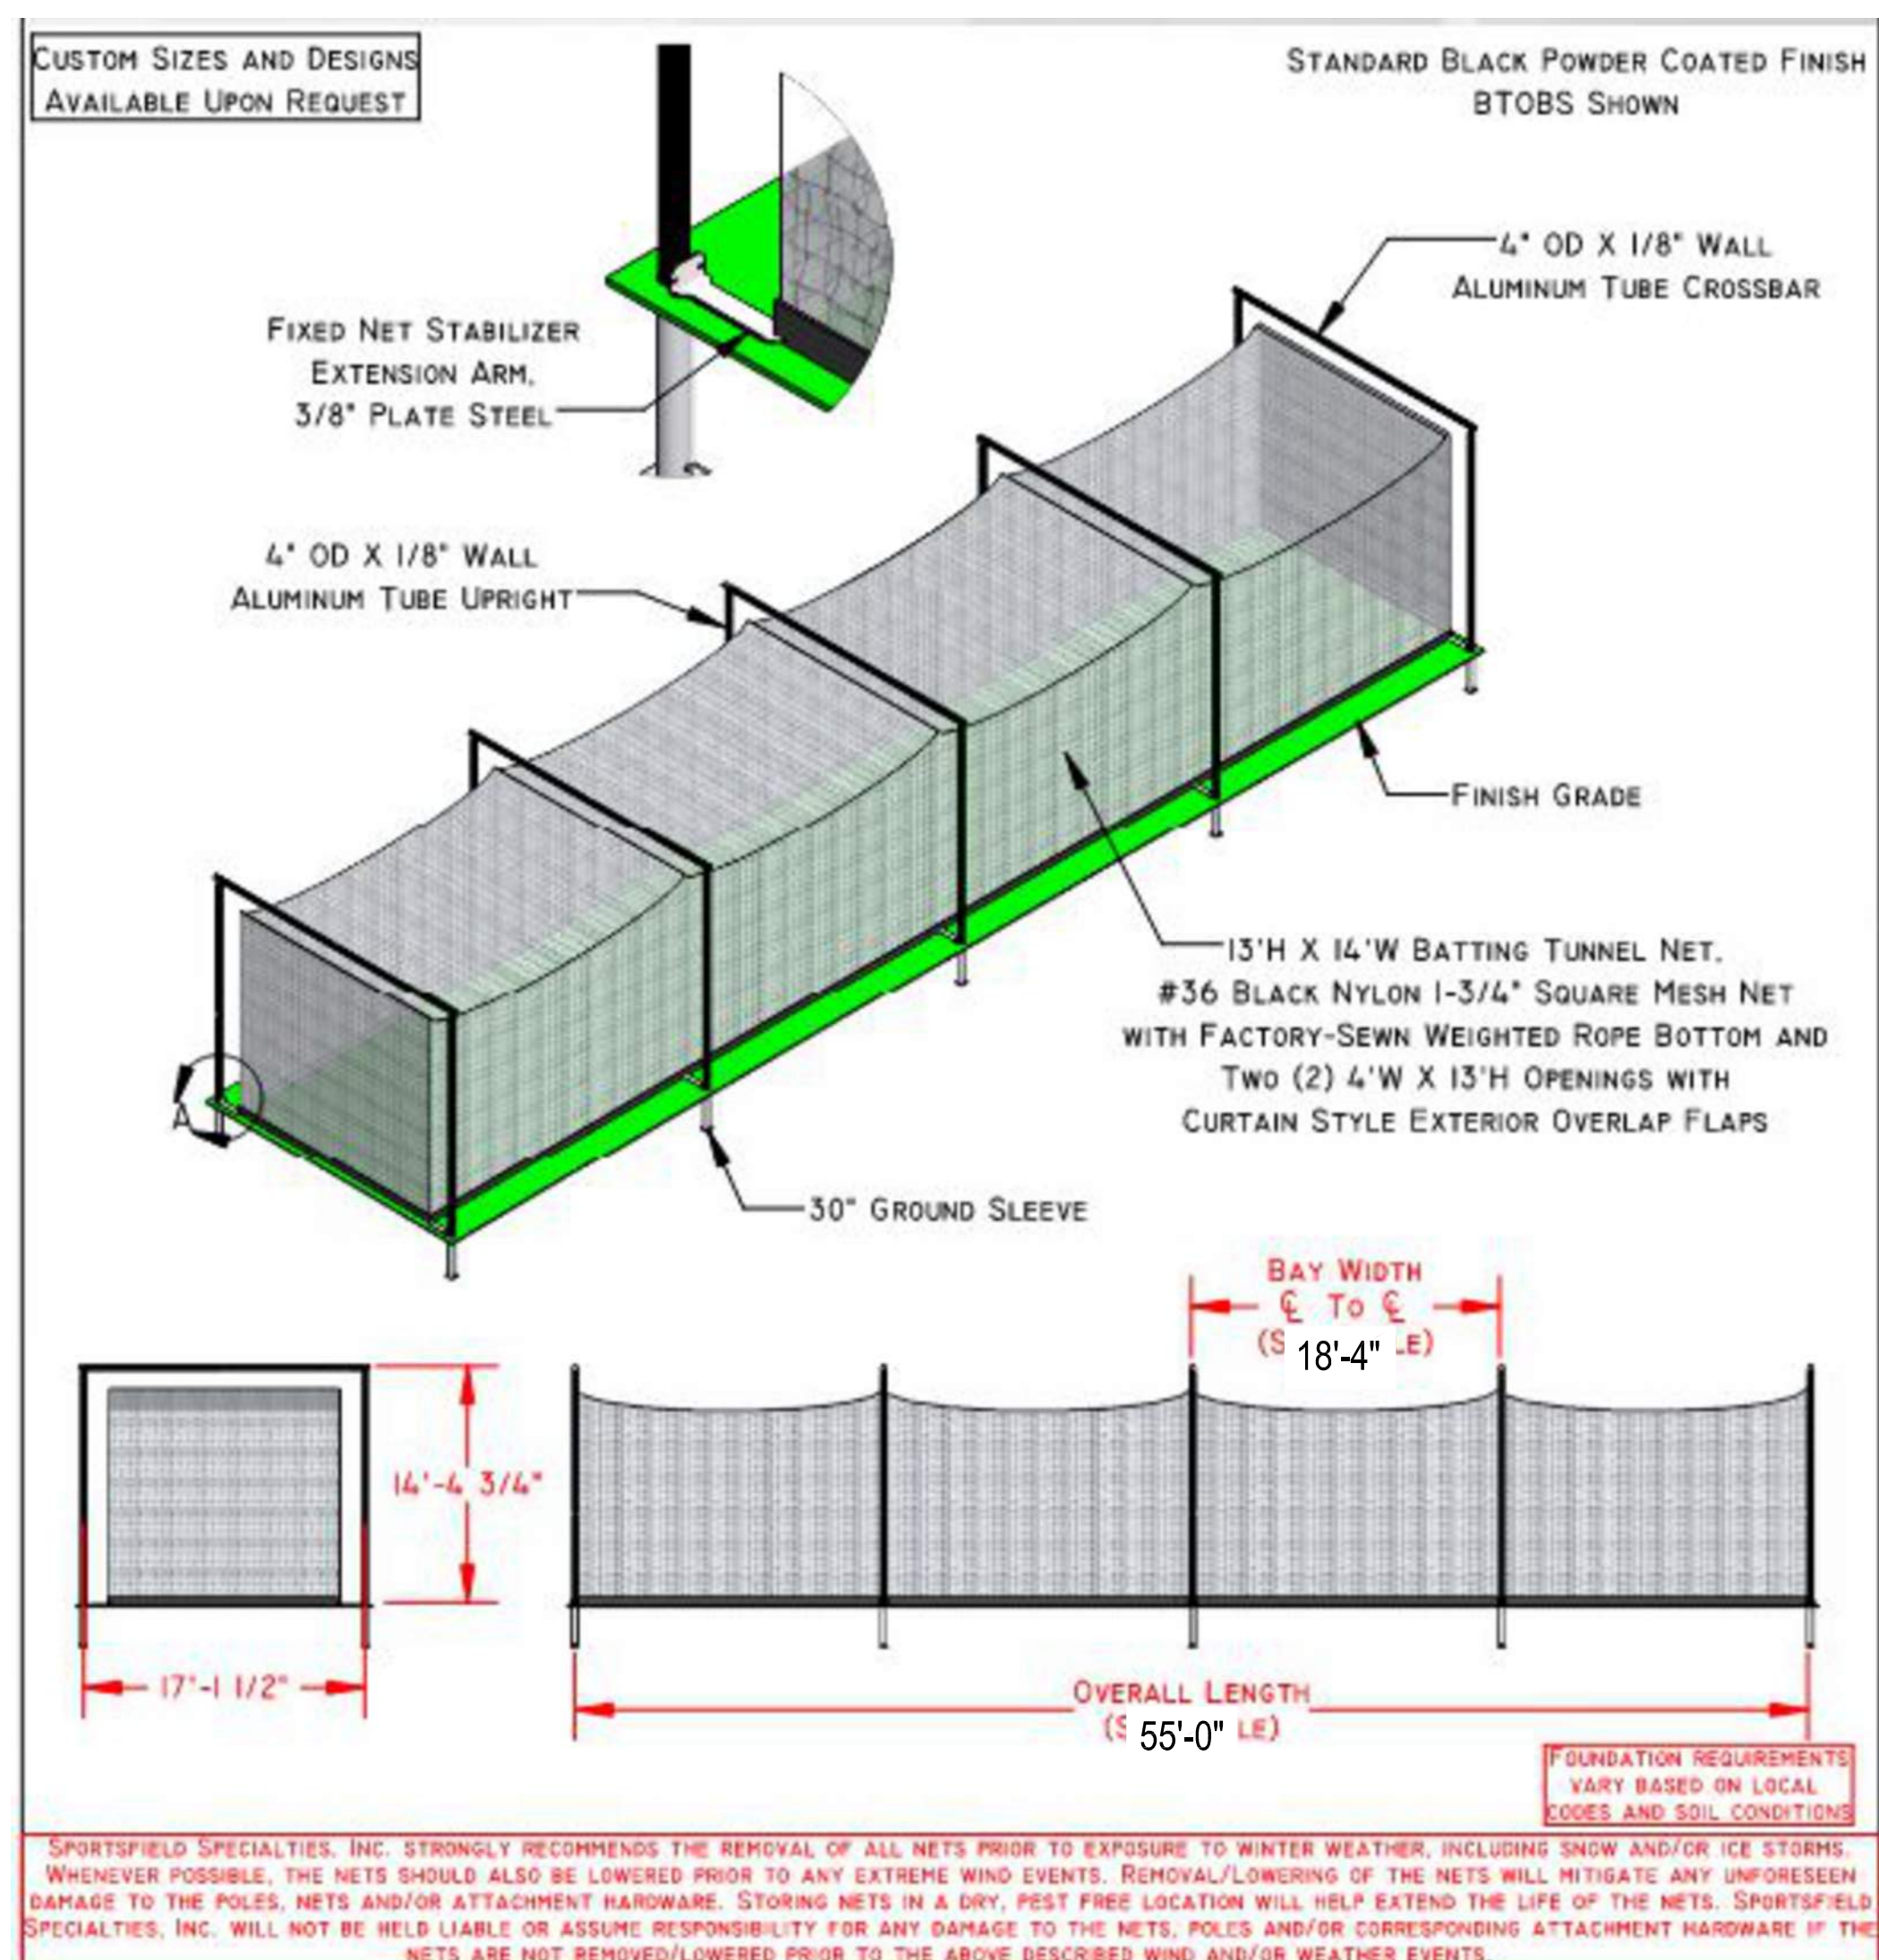

**3 BATTING TUNNEL**

SPORTSFIELD SPECIALTIES OR APPROVED EQUAL


SCALE: N.T.S.

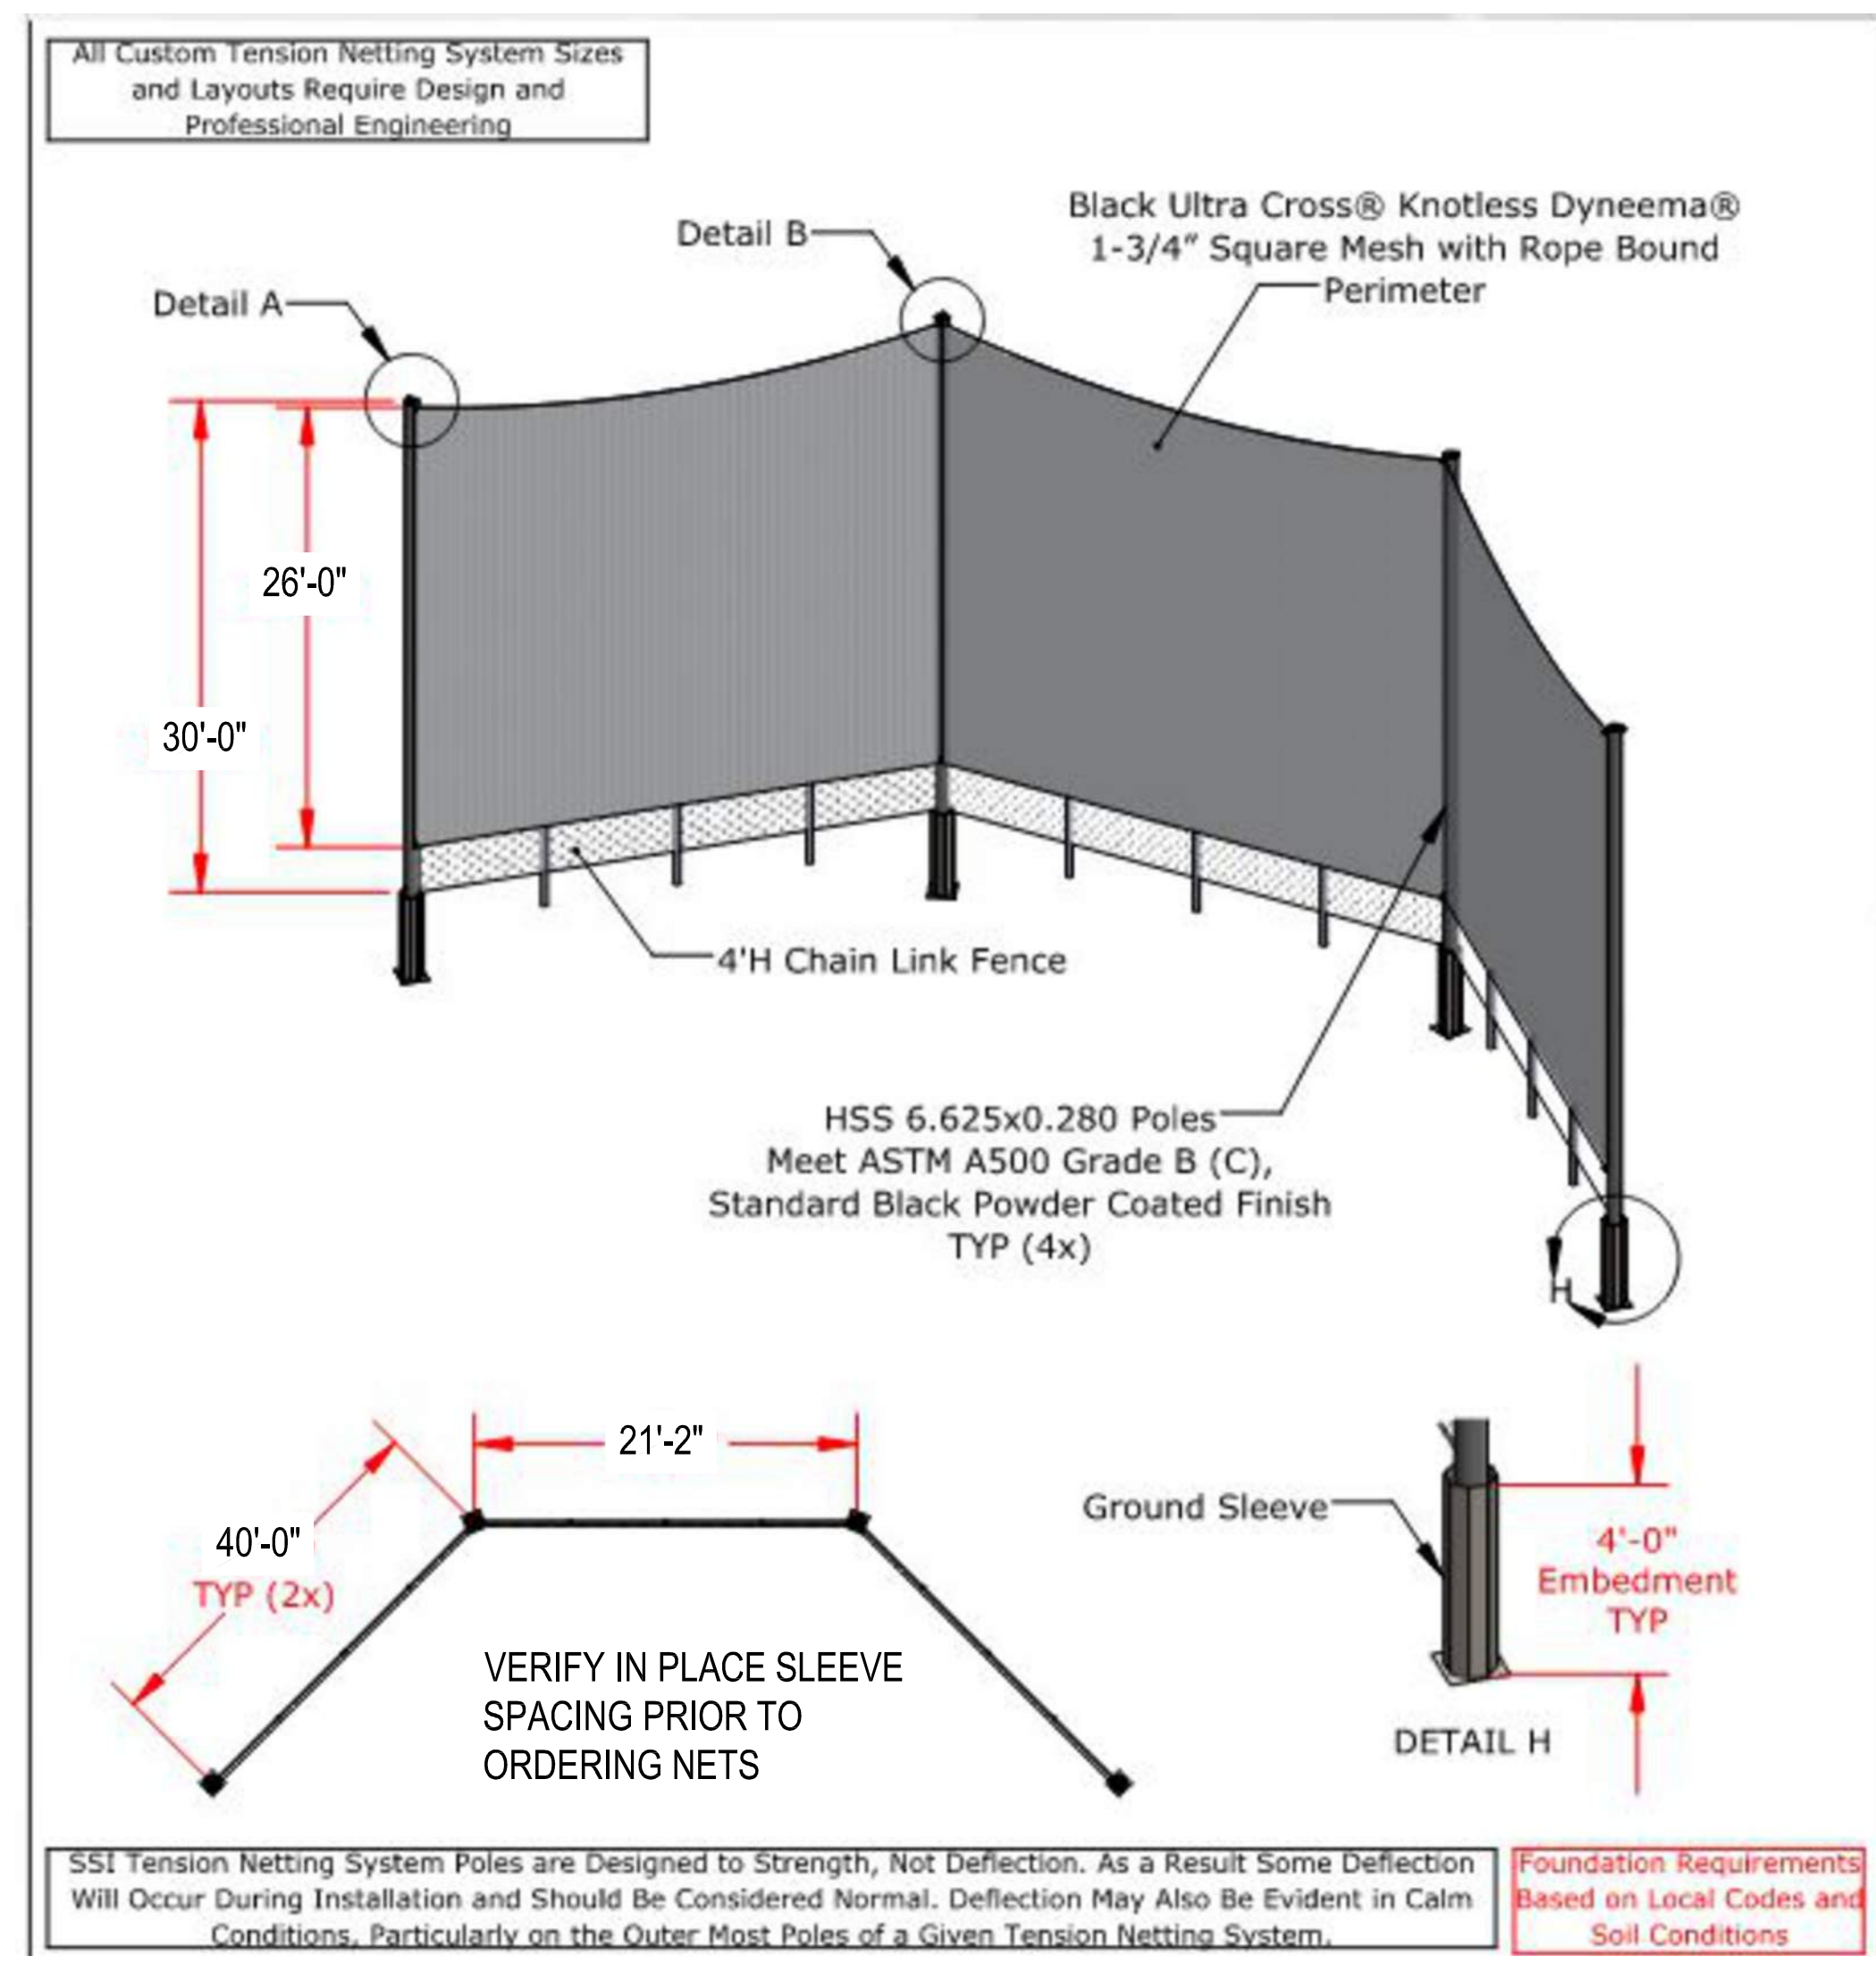

**2 TENSION BACKSTOP NETTING SYSTEM**

SPORTSFIELD SPECIALTIES OR APPROVED EQUAL


SCALE: N.T.S.

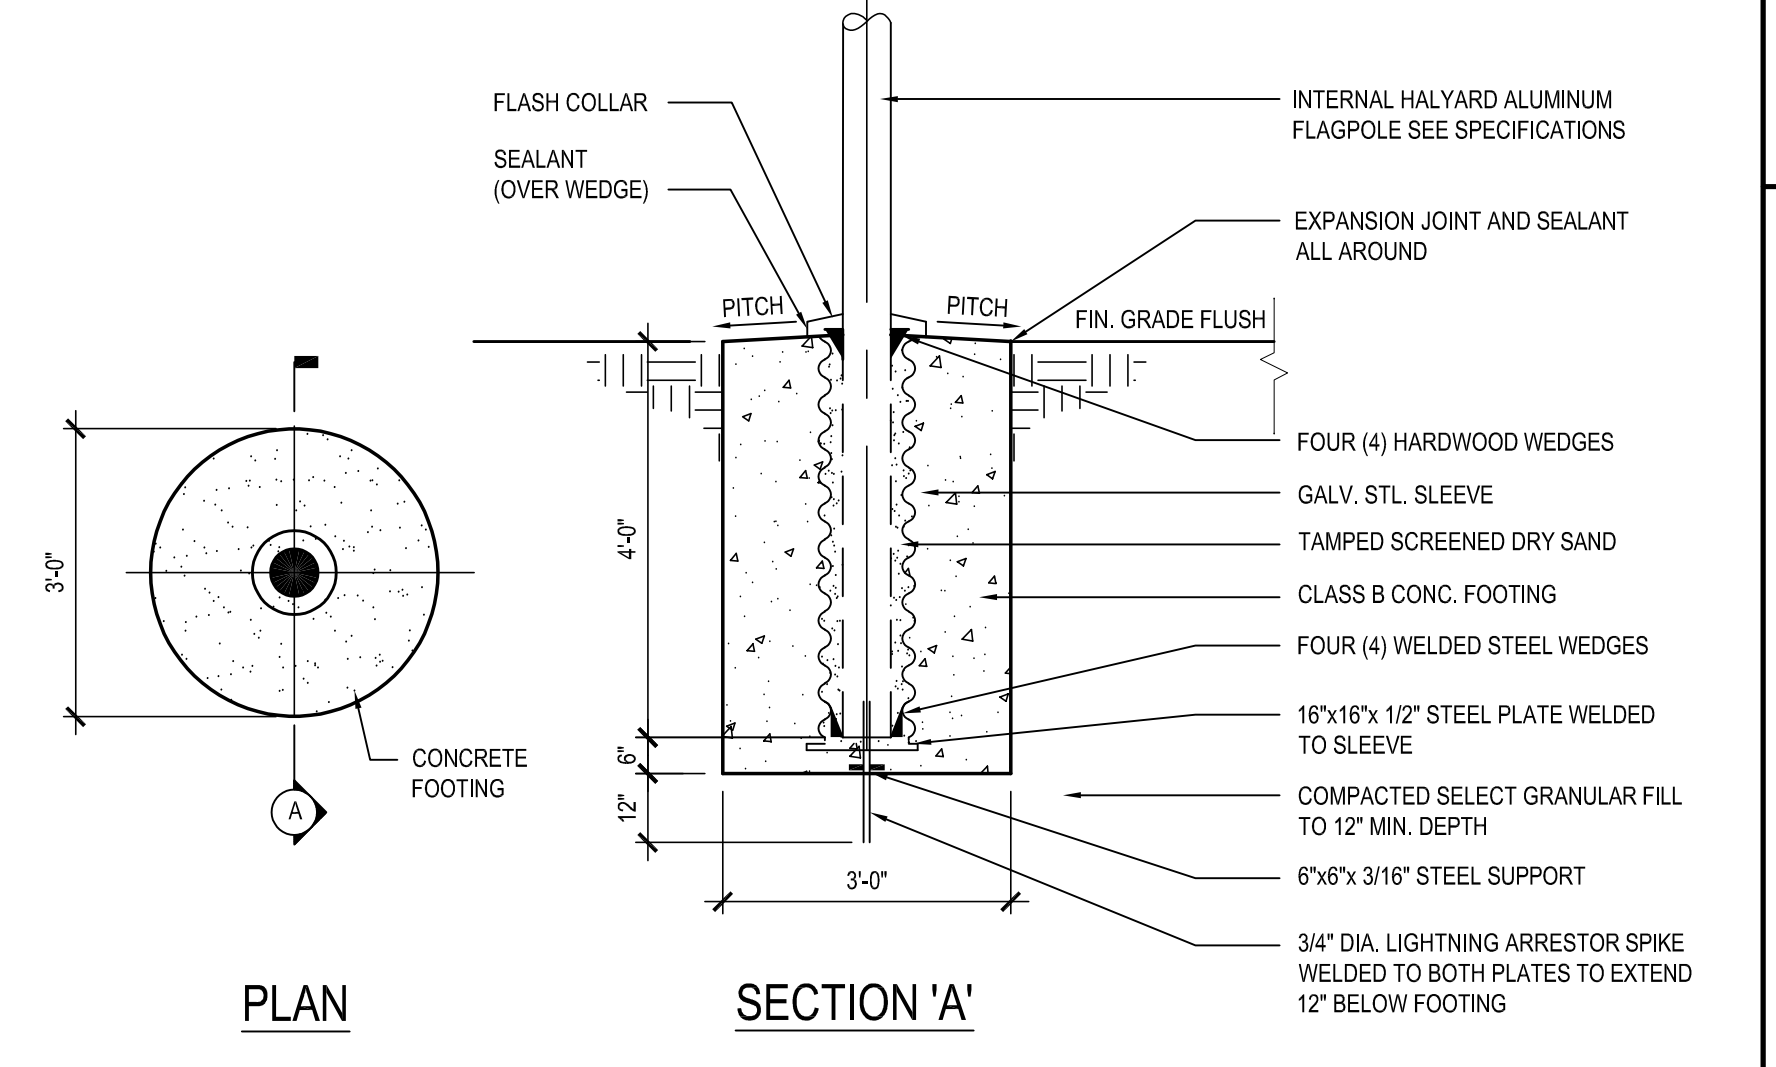

**5 FLAGPOLE FOOTING**


NOTE: REFER TO SPECIFICATION SECTION 107516 FOR MANUFACTURER AND POLE SIZE

SCALE: N.T.S.

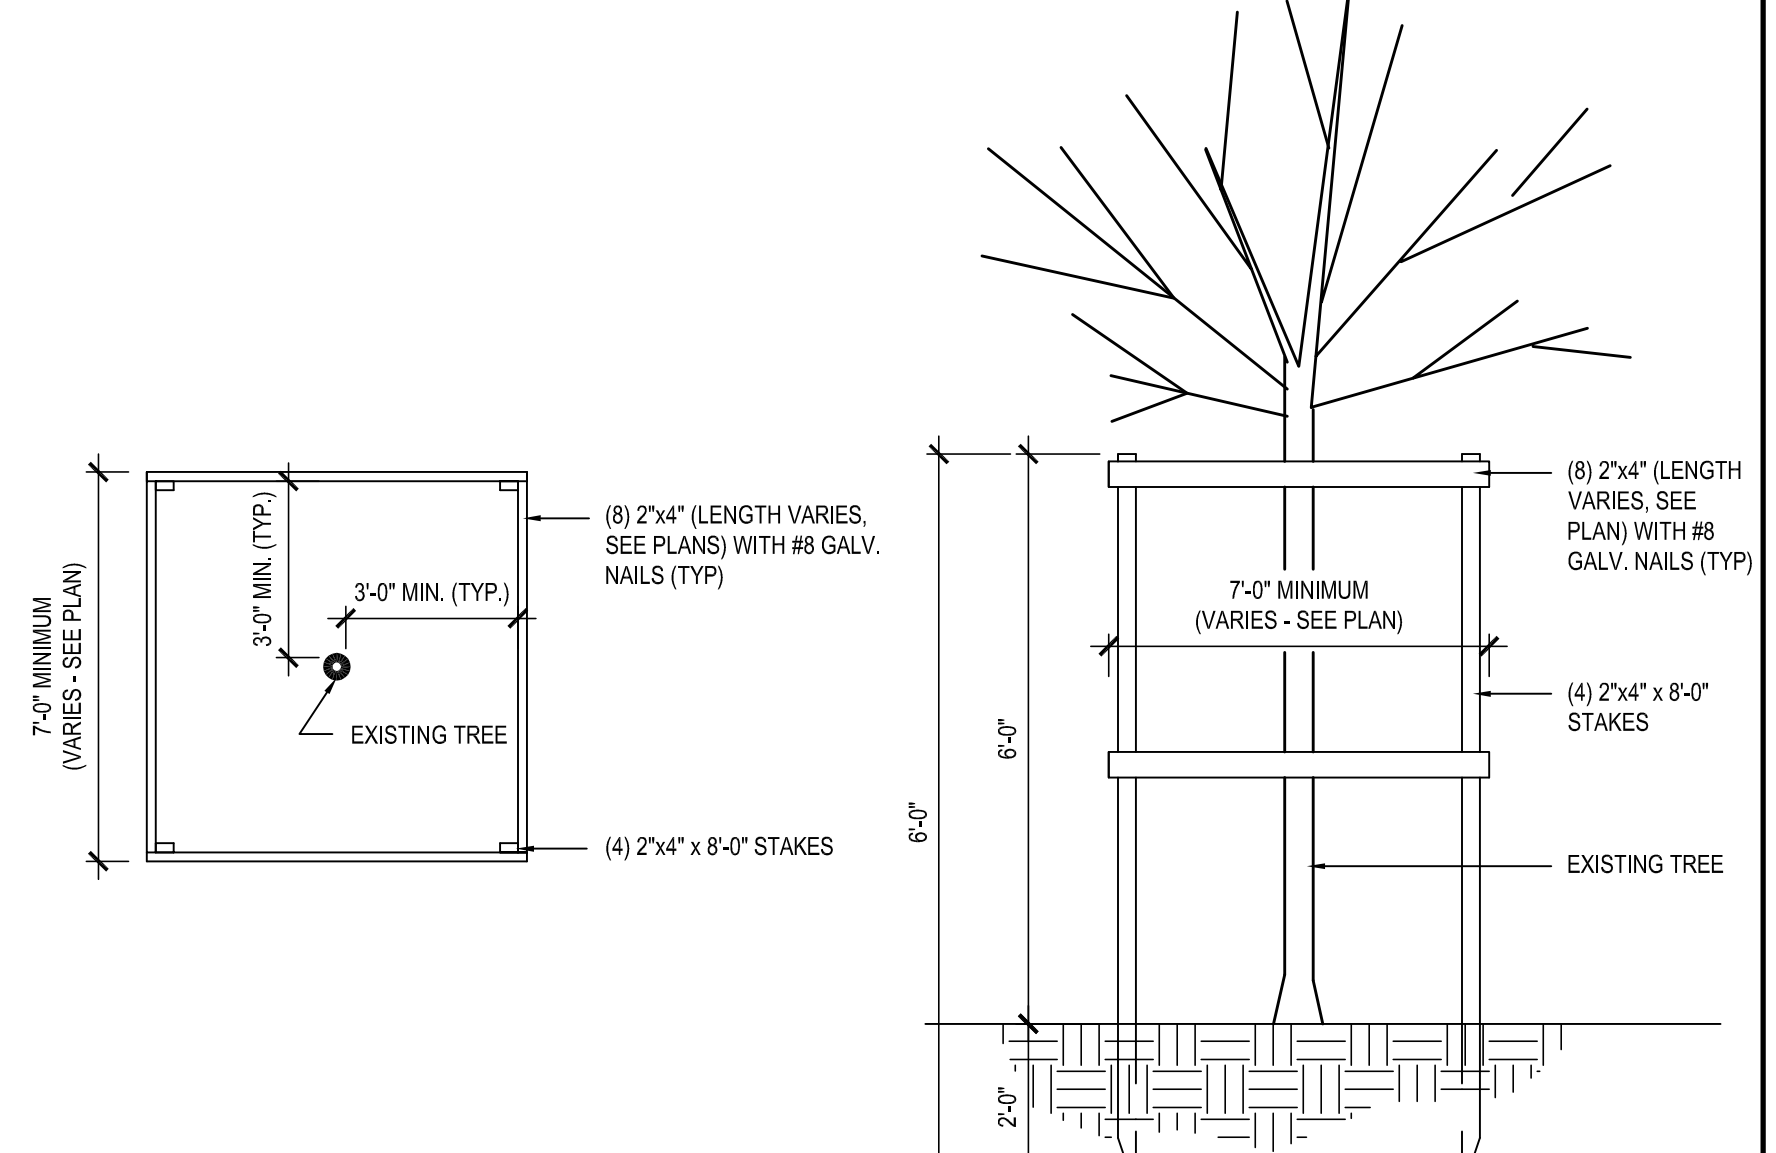

**4 TEMPORARY TREE GUARD DETAIL**

SCALE: N.T.S.

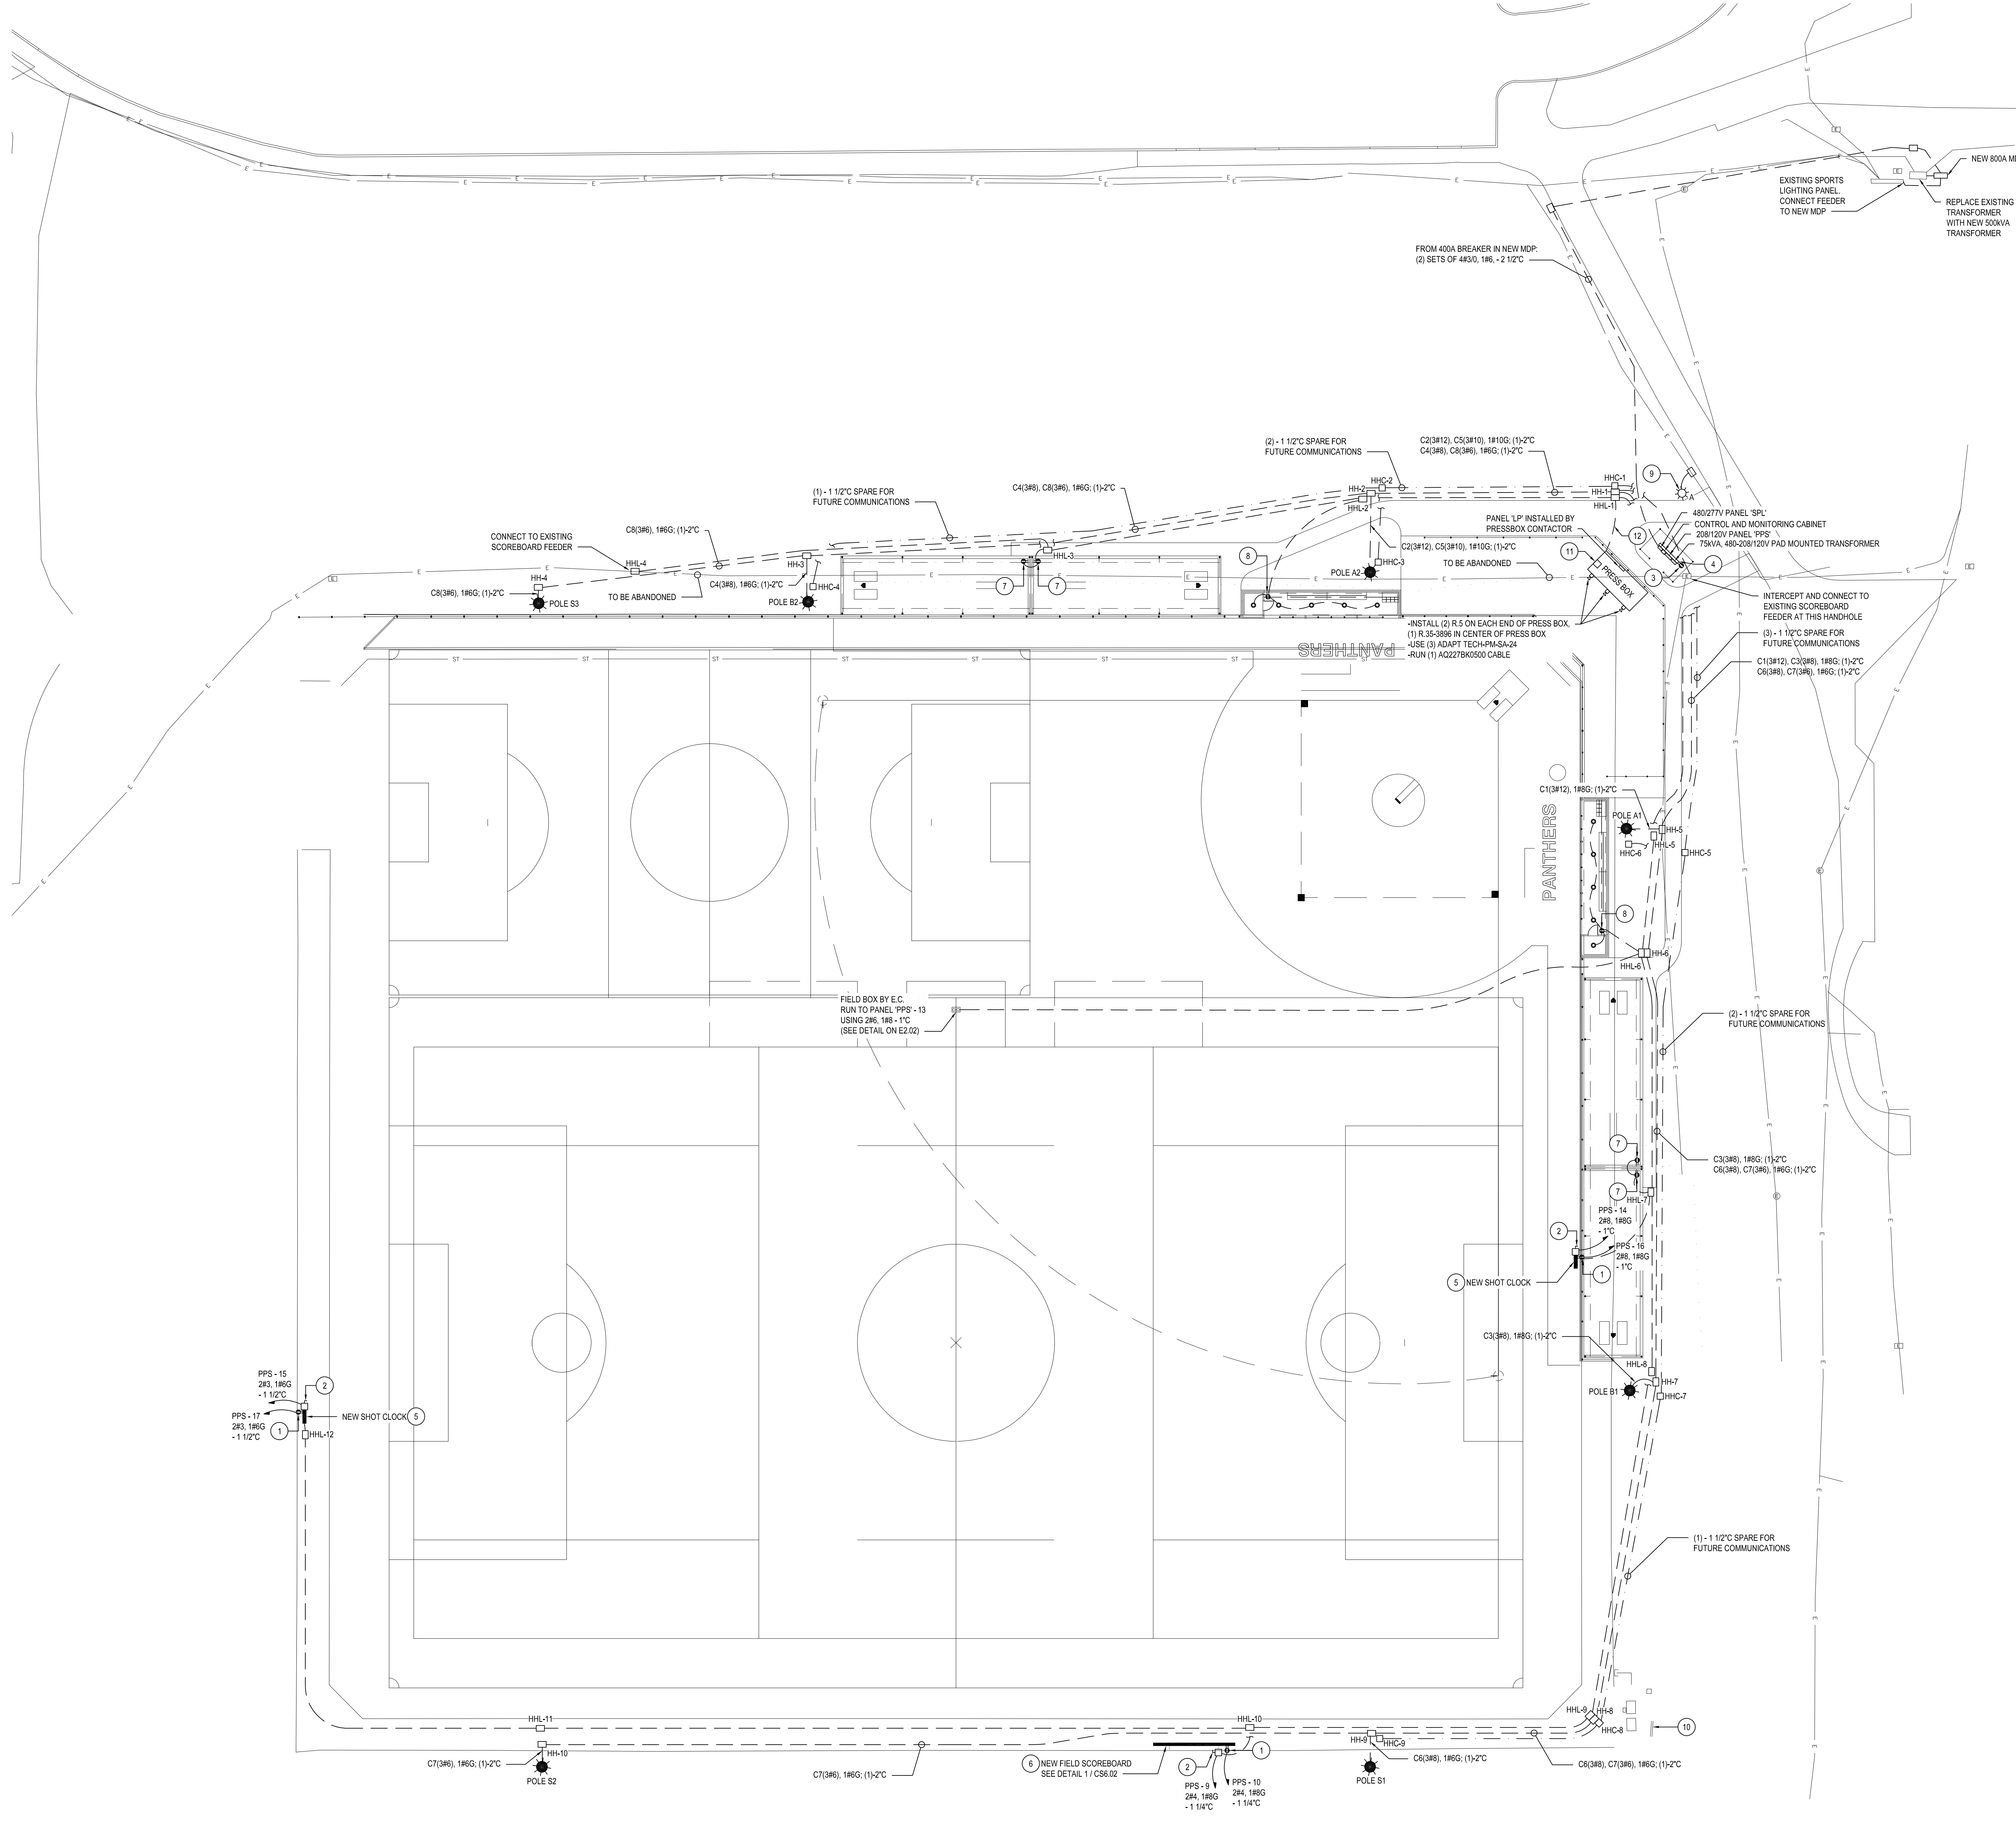

- ### SITE PLAN KEY NOTES
- 125V, 20A GFI DUPLEX RECEPTACLE, NEMA 5-20R, WITH 302/304 STAINLESS STEEL FACEPLATE IN SURFACE MOUNTED WEATHER PROOF IN-HOUSE BOX WITH LOCKABLE COVER. SEE E2.02 FOR PANEL SCHEDULE.
  - 120V, 30A, NEMA 3R, LOCKABLE, UNFUSED DISCONNECT SWITCH FOR NEW SHOT CLOCK/SCOREBOARD. PROVIDE AND INSTALL EXTERIOR KINDORF FRAMING FOR NEW DISCONNECT SWITCH MOUNTING.
  - 125V, 20A GFI DUPLEX RECEPTACLE, NEMA 5-15R, WITH 302/304 STAINLESS STEEL FACEPLATE IN SURFACE MOUNTED WEATHER PROOF BOX MOUNT ON H-FRAME RACK AND WIRE TO PANEL 'PPS' CIRCUIT #3 WITH 2#12, 1#12G - 3#12.
  - MOUNT 400A PANEL 'SPL', 200A PANEL 'PPS', AND CONTROL CABINET ON KINDORF H-FRAME. SEE DETAILS ON E2.02/E2.03. MOUNT NEW 78KVA TRANSFORMER ON CONCRETE PAD BESIDE H-FRAME.
  - NEW SHOT CLOCK PER PLAN FURNISHED & INSTALLED BY ELECTRICAL CONTRACTOR. SUPPORTS & FOUNDATION BY SITE CONTRACTOR. MODEL No. T12015. REFER TO SPEC 116843 FOR ADDITIONAL INFORMATION.
  - NEW SCOREBOARD PER PLAN FURNISHED & INSTALLED BY ELECTRICAL CONTRACTOR. SUPPORTS & FOUNDATION BY SITE CONTRACTOR. MODEL No. DAKTRONICS BA-2125 AND DAKTRONICS MS-2009. REFER TO DWG. C56.02 & SPEC 116843 FOR ADDITIONAL INFORMATION.
  - DEDICATED BULL PEN GFI RECEPTACLE, RUN 2#8, 1#10 - 1" TO PANEL 'PPS'. SEE E2.02 FOR PANEL SCHEDULE.
  - E.C. TO CONNECT CIRCUIT TO DEDICATED DUGOUT GFI RECEPTACLE ENCLOSURE PROVIDING POWER TO DUGOUT AND DUGOUT LIGHTS. RUN 2#10, 1#10 - 3#12 TO PANEL 'PPS' SEE E2.02 FOR PANEL SCHEDULE.
  - CONNECT NEH AREA LUMINAIRE TO EXISTING 480V UNDERGROUND CIRCUIT. MATCH EXISTING WIRE SIZE AND EXTEND/SHORTEN WIRE AS NEEDED.
  - E.C. TO SAFE-OFF, DISCONNECT, AND REMOVE EXISTING ELECTRICAL PANEL.
  - E.C. TO INSTALL ATHLETIC FIELD SOUND SYSTEM. FINAL LOCATION COORDINATED IN FIELD. RUN 3#12 IN 3/4" TO PRESS BOX PANEL 'LP'. PROVIDE NEW 20A BREAKER FOR CIRCUIT. SEE SPEC FOR MORE INFO.
  - E.C. TO RUN 3#3, 1#6G - 1 1/2" FROM NEW PANEL 'PPS' TO PRESS BOX PANEL 'LP'.

### LIGHTING SCHEDULE

TYPE	SYMBOL	DESCRIPTION
A		DECORATIVE AREA LUMINAIRE BY COOPER LIGHTING - INJUE 129 WATTS, 13,452 LUMENS, 2200K, WITH INTEGRAL PHOTOCELL. POLE SHALL BE 15' ROUND TAPERED ALUMINUM POLE WITH BASE FINISH FINISH SHALL BE BRONZE. MODEL No. MESA-SX2D-72-2-TZ-BZ-MSDIM-20

### CIRCUIT WIRING SCHEDULE

CIRCUIT#	WIRE	LOAD SERVED	REMARKS
C1	3#12	POLE A1	
C2	3#12	POLE A2	
C3	3#8	POLE B1	
C4	3#8	POLE B2	
C5	3#10	POLE A2	
C6	3#8	POLE S1	
C7	3#8	POLE S2	
C8	3#8	POLE S3	

NOTE: EQUIPMENT GROUND NOT INCLUDED IN ABOVE. SEPARATE COMMON EQUIPMENT GROUND PROVIDED IN CONDUIT. SEE SITE PLAN.

REV.	DATE	ITEM

**NOTICE**  
 THESE DRAWINGS ARE BASED ON CONSTRUCTION DRAWINGS NOT PREPARED BY BBS ARCHITECTS, LANDSCAPE ARCHITECTS AND ENGINEERS, P.C. AND, THEREFORE, MAY NOT REPRESENT THE CONDITIONS AS CONSTRUCTED AT THE TIME. ALL EXISTING CONDITIONS SHOWN ARE REPRESENTED AS SUGGESTIVE INFORMATION AS THEY MAY NOT HAVE BEEN BUILT AND SET BACK PER THE ORIGINAL DOCUMENTS OR PER THE OWNER'S INFORMATION.



KEY PLAN  
 NOT TO SCALE

PROJECT  
 MULTI-PURPOSE SYNTHETIC TURF FACILITY  
 PURCHASE COLLEGE  
 STATE UNIVERSITY OF NEW YORK  
 735 ANDERSON HILL ROAD, PURCHASE, NEW YORK 10577

DWG TITLE  
 ELECTRICAL SITE PLAN

DRAWING BY: RP  
 CHECK BY: JRL


**NOTICE**  
 THIS DRAWING PREPARED FOR THE SPECIFIC PROJECT INDICATED IS AN INSTRUMENT OF SERVICE AND, THE PROPERTY OF BBS ARCHITECTS, LANDSCAPE ARCHITECTS AND ENGINEERS, P.C. REPRODUCTION IN ANY FORM OR BY ANY MEANS WITHOUT THE WRITTEN CONSENT OF THE ARCHITECT/ENGINEER IS PROHIBITED. ANY ALTERATION OR REPRODUCTION OF THIS DOCUMENT IS ALSO PROHIBITED WITHOUT THE WRITTEN CONSENT OF THE ARCHITECT/ENGINEER.

**BBS**  
 ARCHITECTS  
 LANDSCAPE ARCHITECTS  
 ENGINEERS

244 EAST MAIN STREET  
 PATERBOUGH  
 NEW YORK 11772  
 T. 631.475.0349  
 F. 631.475.0361

187 WOLF ROAD, STE. 205  
 ALBANY  
 NEW YORK 12205  
 T. 518.621.7650  
 F. 518.621.7655

www.bbsarchitecture.com

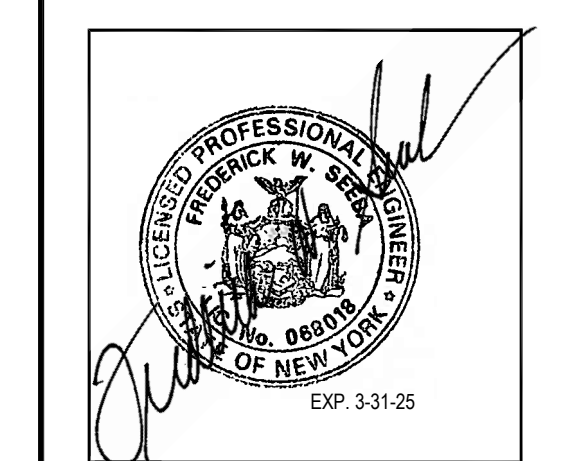


CONTRACT No. SU-022823 - GENERAL CONST.  
 SU-022823 - ELECTRICAL

CLIENT  
 SUNY  
 PURCHASE COLLEGE

PROJECT  
 MULTI-PURPOSE  
 SYNTHETIC TURF FACILITY

DWG TITLE  
 ELECTRICAL SITE PLAN


SCALE: AS NOTED  
 DATE: OCTOBER 25, 2023  
 BID PICK-UP:  
 FILE No: 23-158

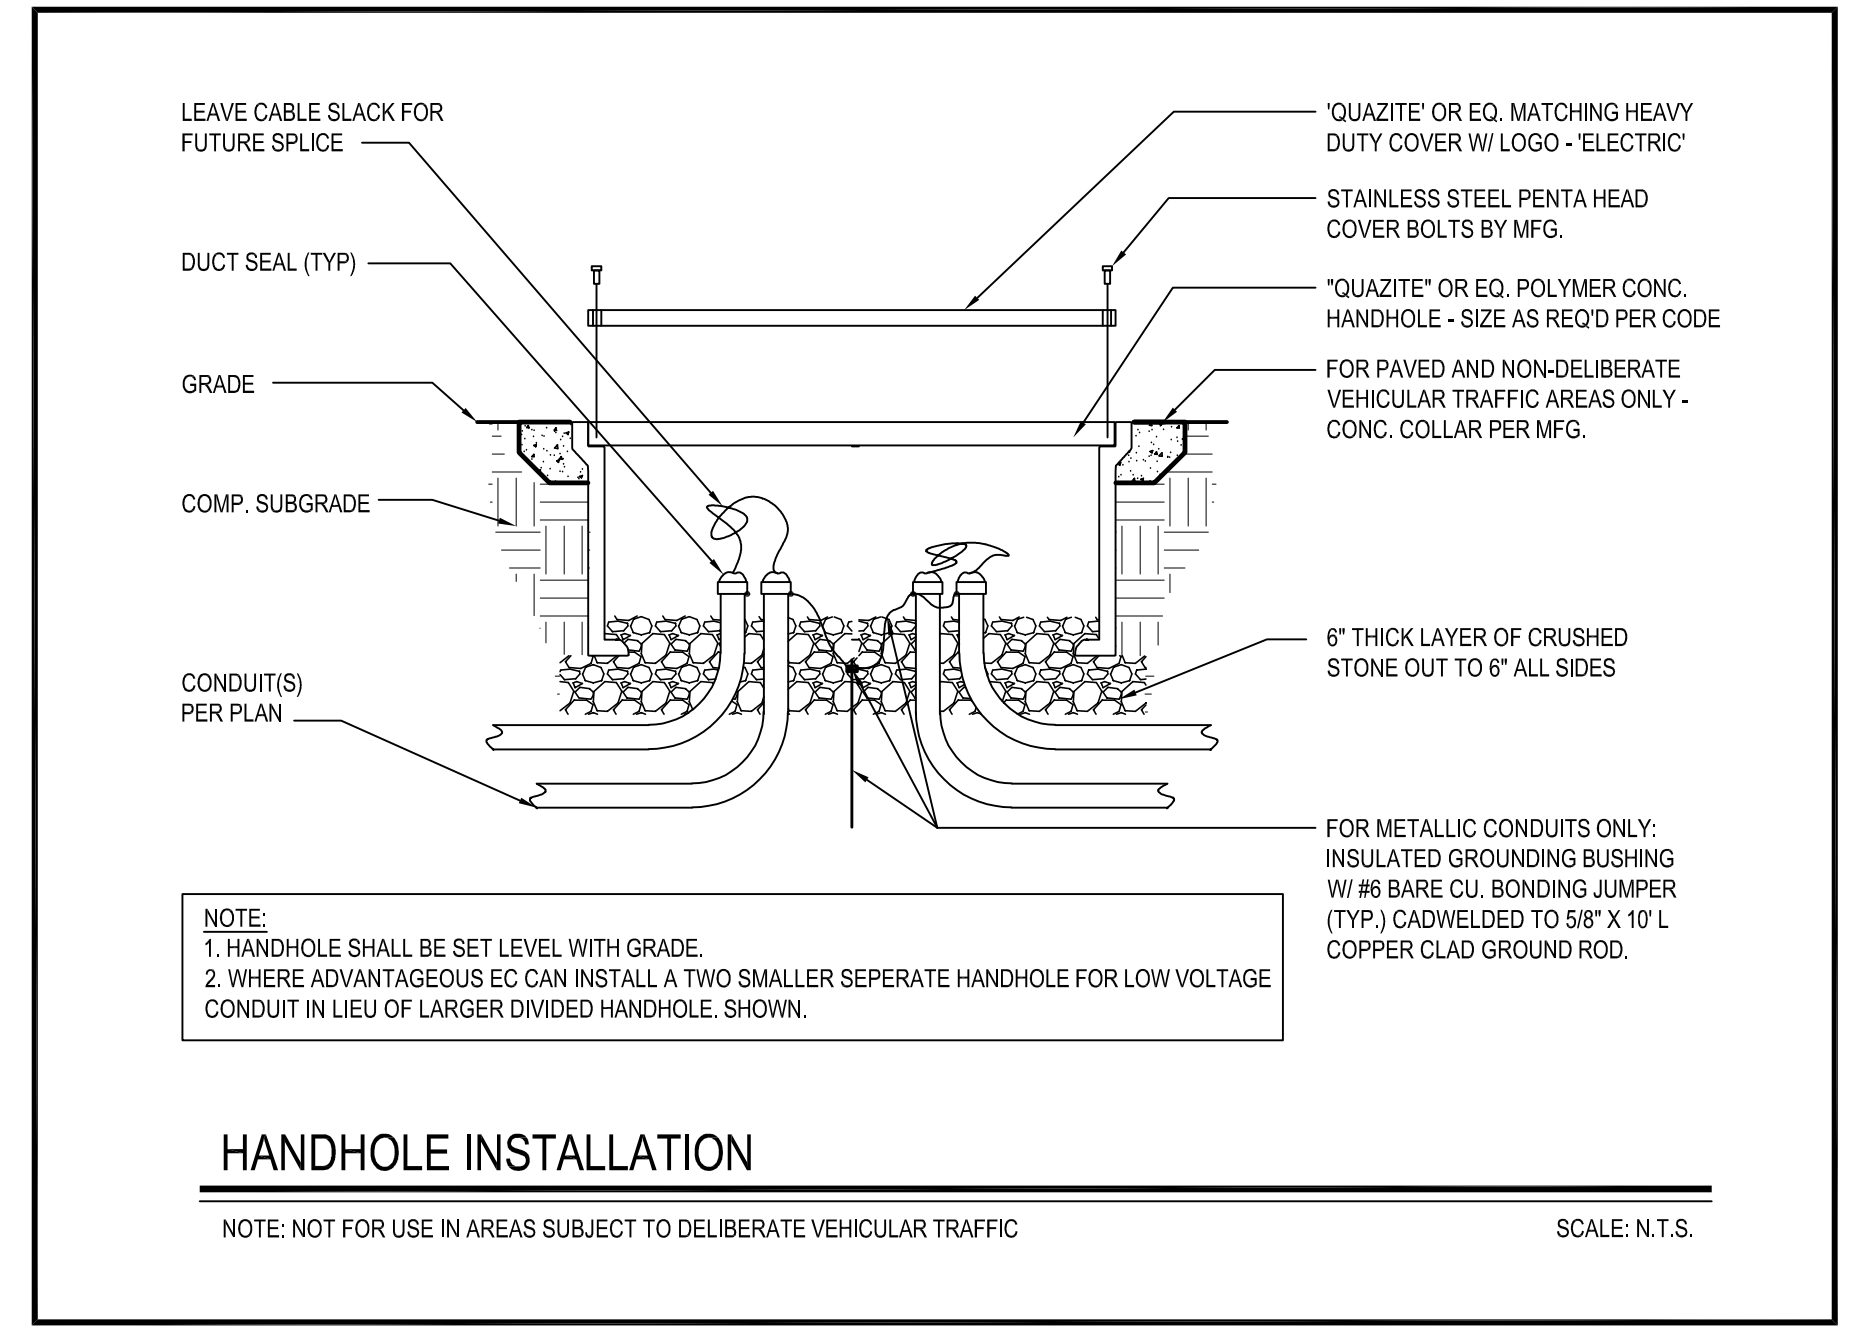

**HANDHOLE INSTALLATION**


NOTE: NOT FOR USE IN AREAS SUBJECT TO DELIBERATE VEHICULAR TRAFFIC

SCALE: N.T.S.

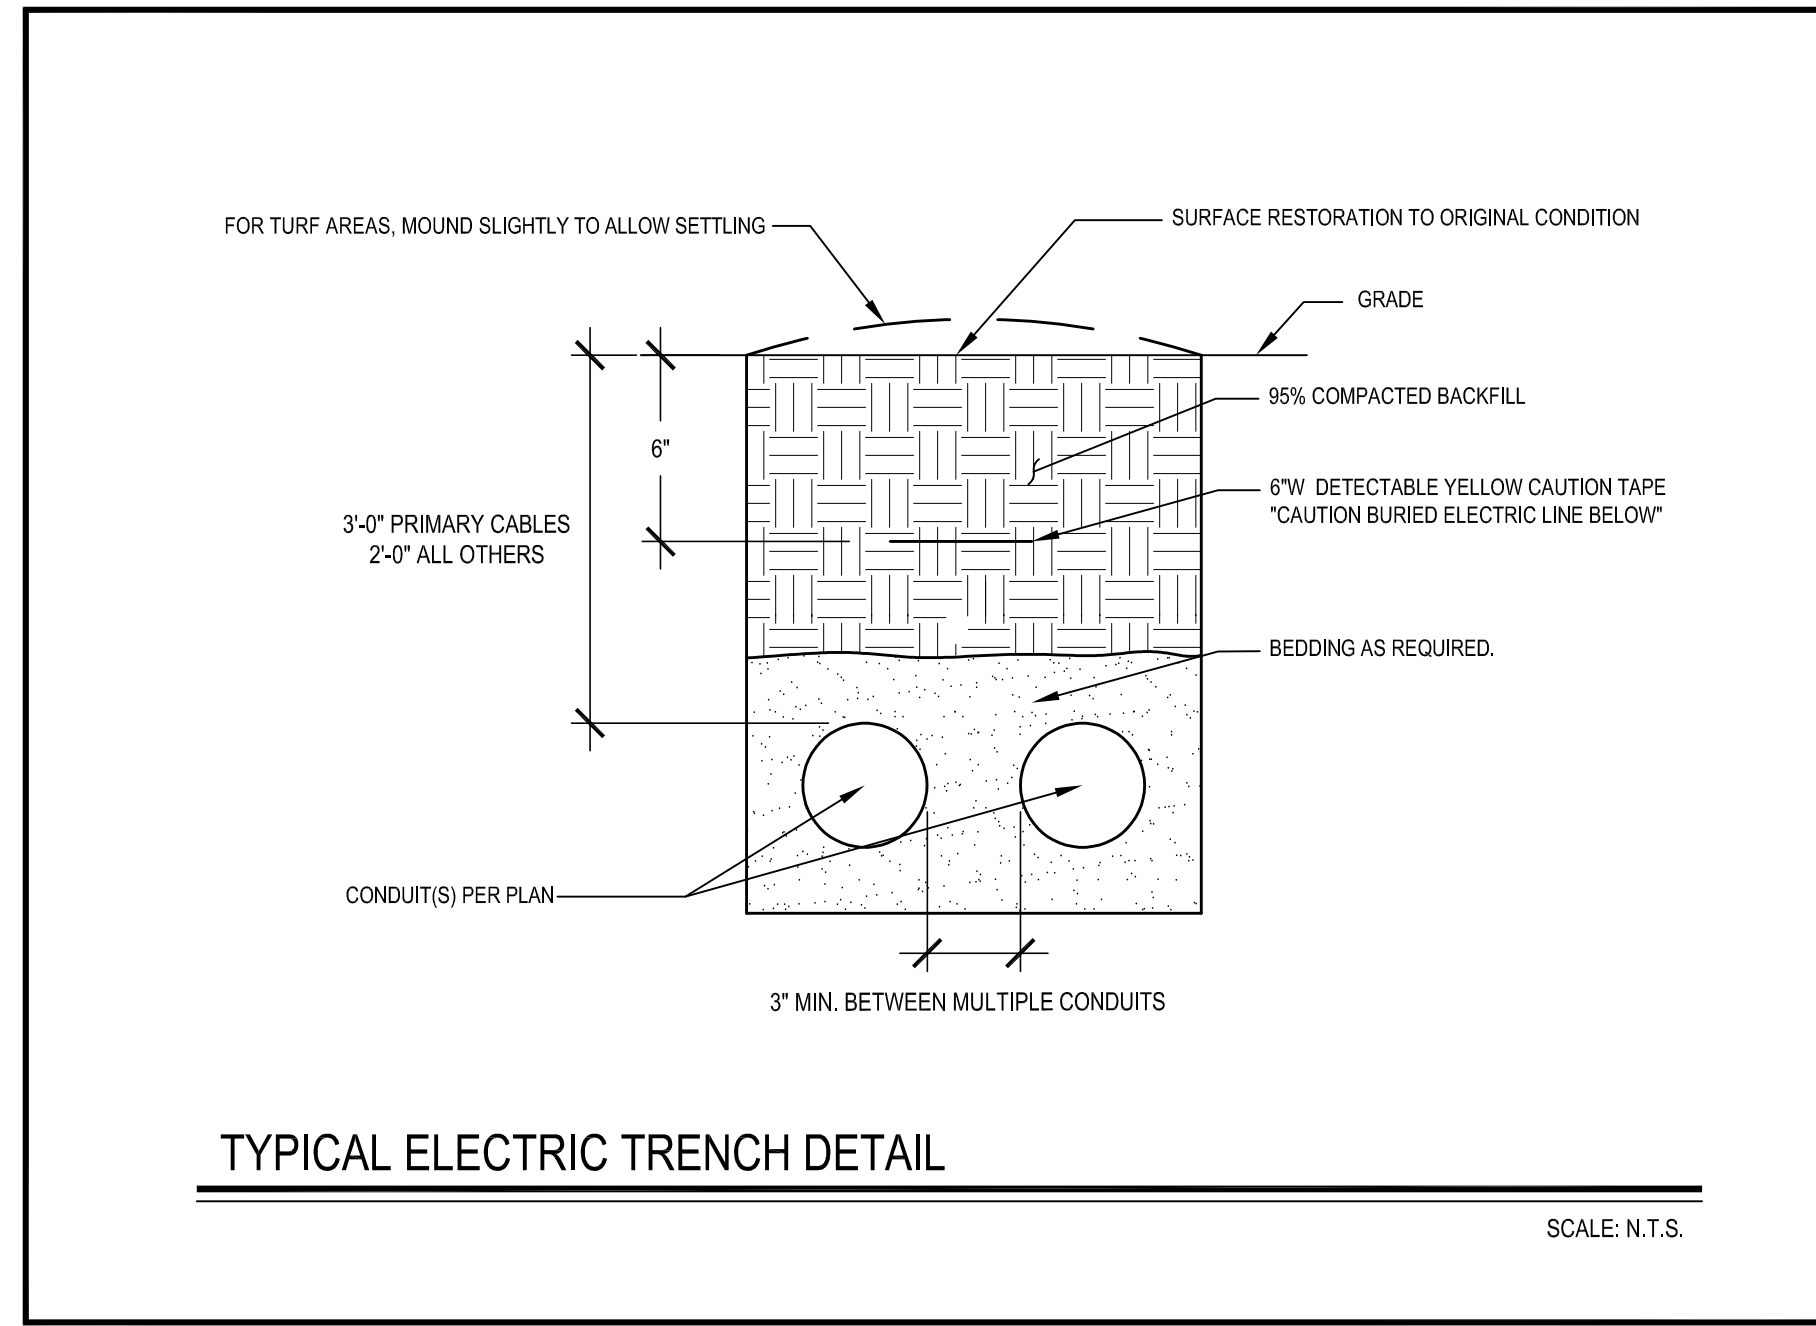



**TYPICAL ELECTRIC TRENCH DETAIL**

SCALE: N.T.S.

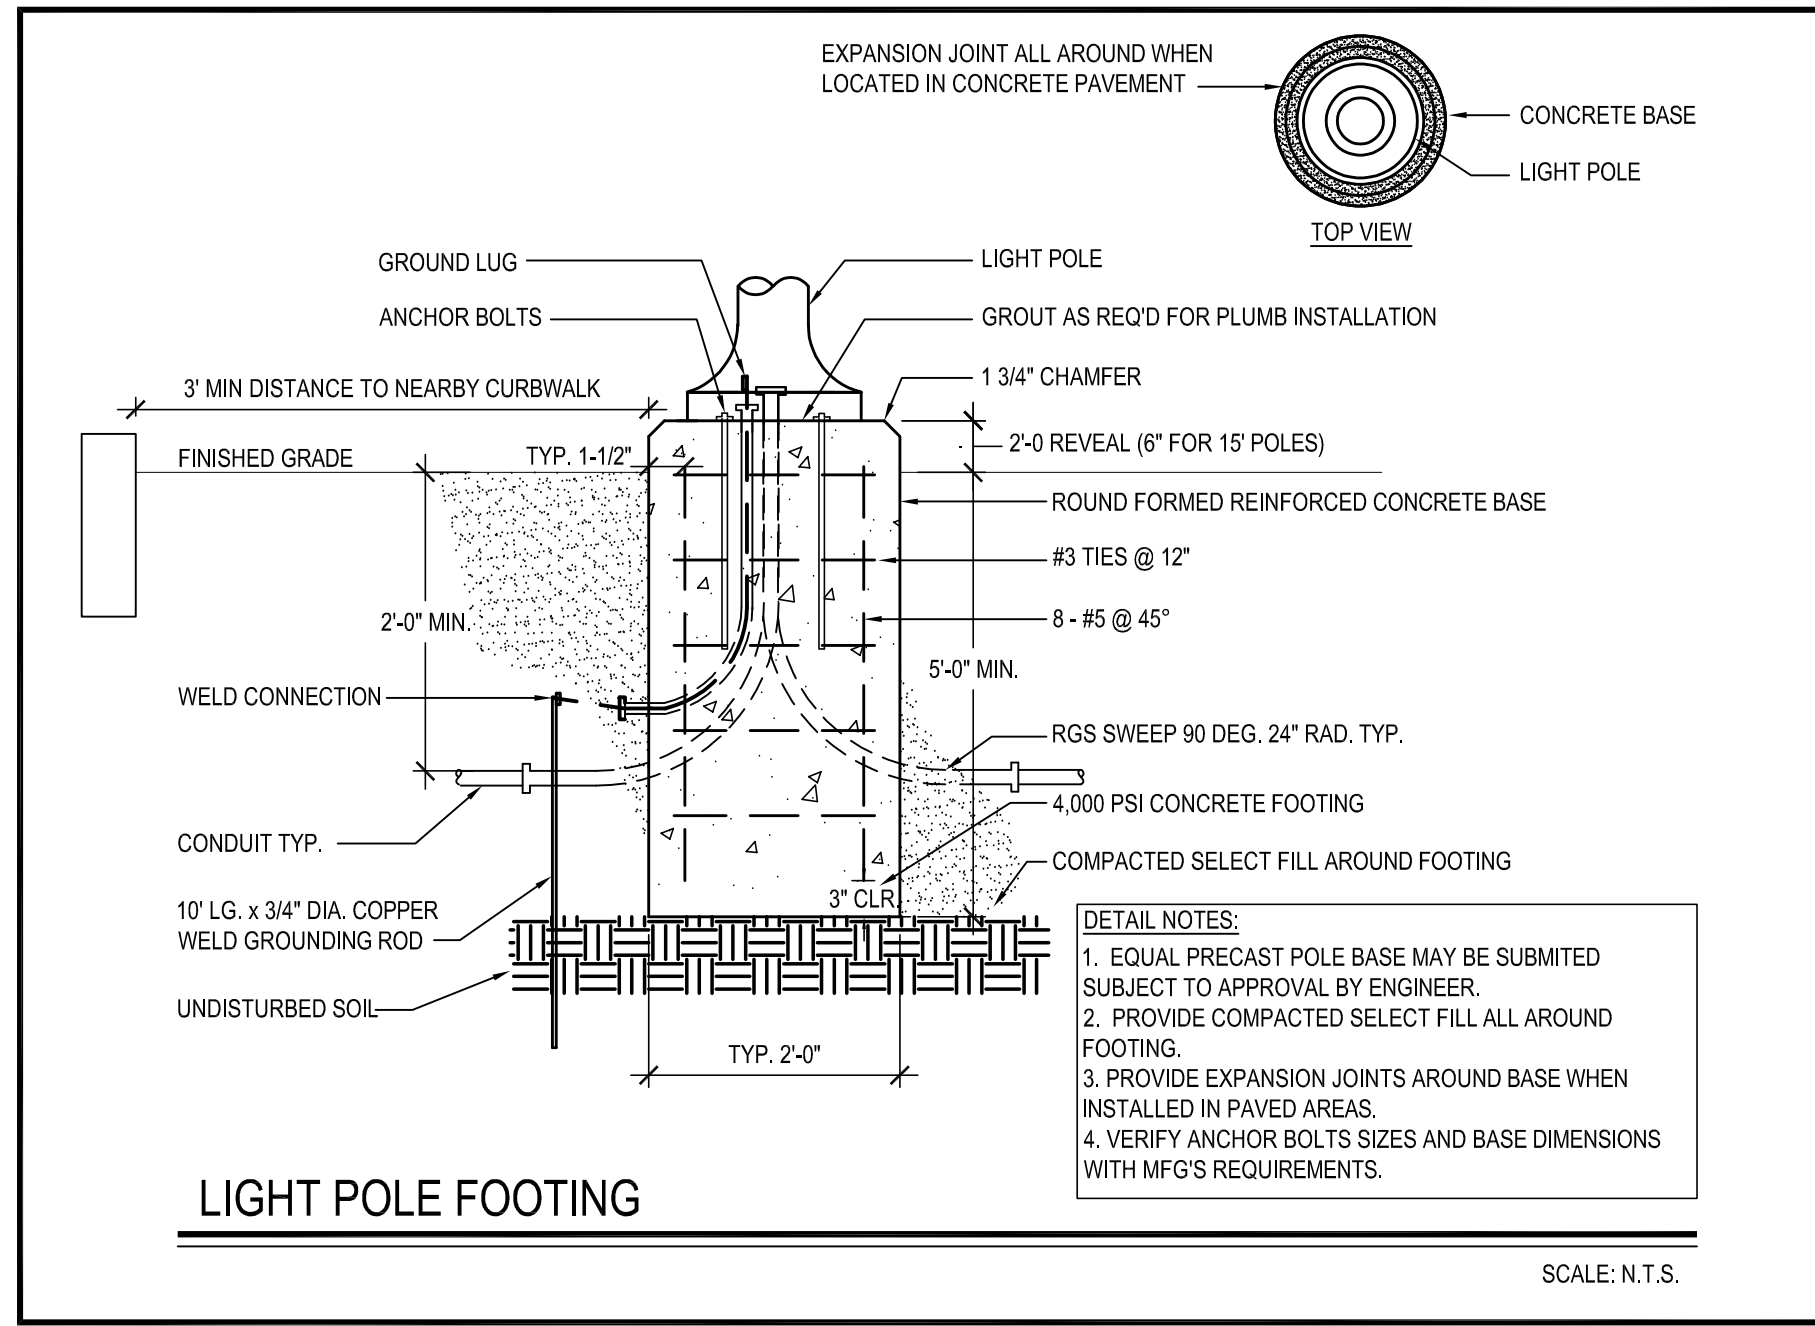

**LIGHT POLE FOOTING**

SCALE: N.T.S.

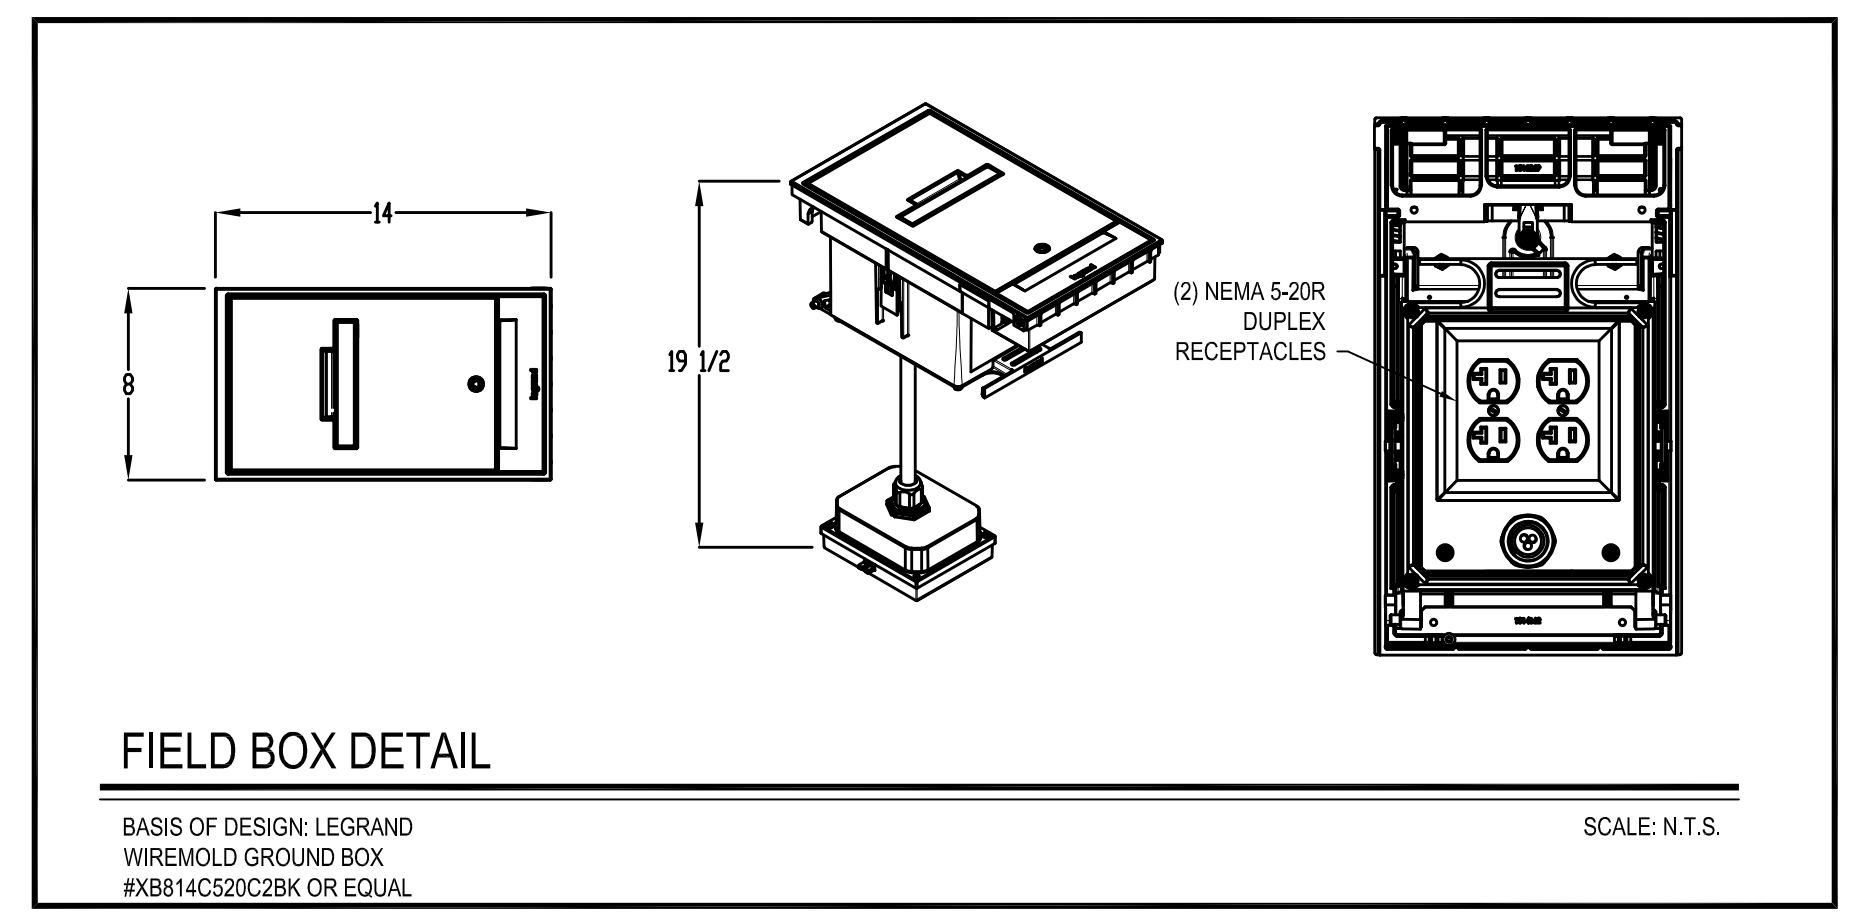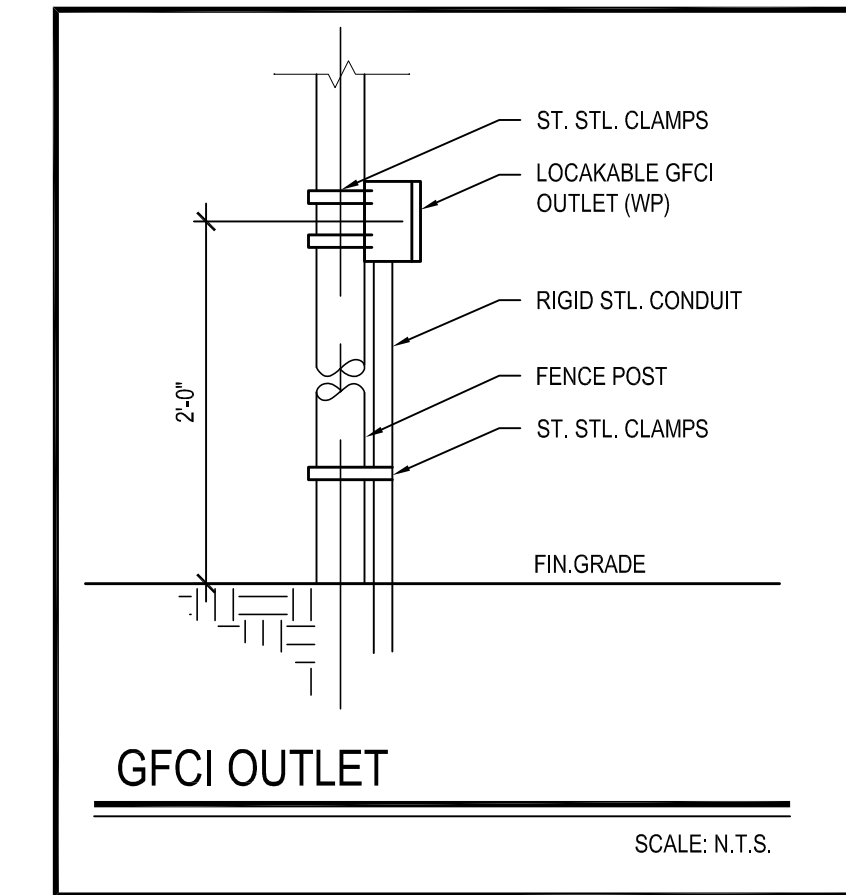

**FIELD BOX DETAIL**

**PANEL BOARD NAME: SPL LOCATION: OUTDOORS**

TYPE: \_\_\_\_\_ BRANCH BREAKER TYPE: BOLT ON NO. OF POLES: AS SHOWN BUS SIZE (A): 400A

MIN AIC RATING (KA): 35K NEUTRAL: 400A MAIN CIRCUIT BREAKER: 400A

MAIN LUGS: (2) SETS #3/0 VOLTS: 480/277V PHASE: 3 # WIRES: 4

MOUNTING: SURFACE ENCL. TYPE: 3R DOOR REOD: LOCKABLE

ACCESSORIES: SURGE PROTECTIVE DEVICE (SPD):  SPD RATING(KA): N/A SUB-FEED LUGS:  FEED-THRU LUGS:  SHUNT TRIP MAN:  ASCO SWITCH:  ISOLATED GROUND:

CKT. #	DESIGNATION	WIRE SIZE	CKT. BRKR.	LOAD			CKT. BRKR.	WIRE SIZE	DESIGNATION	CKT. #
				A	B	C				
1	POLE A1 - SOFTBALL LIGHTS (CKT 1)	12	20A			20A	12	POLE A2 - SOFTBALL LIGHTS (CKT 2)	2	
3									4	
5									6	
7	POLE B1 - SOFTBALL LIGHTS (CKT 3)	8	25A			25A	8	POLE B2 - SOFTBALL LIGHTS (CKT 4)	8	
9									10	
11									12	
13	POLE A2 - MULTIPURPOSE LIGHTS (CKT 5)	10	35A			20A	8	POLE S1 - MULTIPURPOSE LIGHTS (CKT 6)	14	
15									16	
17									18	
19	POLE S2 - MULTIPURPOSE LIGHTS (CKT 7)	8	20A			35A	6	POLE S3 - MULTIPURPOSE LIGHTS (CKT 8)	20	
21									22	
23									24	
25	BLANK					125A	1	480-208/120V STEP DOWN TRANSFORMER	26	
27	BLANK								28	
29	BLANK								30	
31	BLANK								32	
33	BLANK								34	
35	BLANK								36	
37	BLANK								38	
39	BLANK								40	
41	BLANK								42	

**PANEL BOARD NAME: PPS LOCATION: OUTDOORS**

TYPE: \_\_\_\_\_ BRANCH BREAKER TYPE: BOLT ON NO. OF POLES: AS SHOWN BUS SIZE (A): 225


MIN AIC RATING (KA): 35K NEUTRAL: 225 MAIN CIRCUIT BREAKER: 200A

MAIN LUGS: 4/0 VOLTS: 208/120V PHASE: 3 # WIRES: 4


MOUNTING: SURFACE ENCL. TYPE: 3R DOOR REOD: LOCKABLE

ACCESSORIES: SURGE PROTECTIVE DEVICE (SPD):  SPD RATING(KA): N/A SUB-FEED LUGS:  FEED-THRU LUGS:  SHUNT TRIP MAN:  ASCO SWITCH:  ISOLATED GROUND:

CKT. #	DESIGNATION	WIRE SIZE	CKT. BRKR.	LOAD			CKT. BRKR.	WIRE SIZE	DESIGNATION	CKT. #
				A	B	C				
1	CONTROL POWER CIRCUIT	12	20A			100A	3	PRESS BOX PANEL	2	
3	H-FRAME RECEPTACLE	12	20A						4	
5	BULL PEN RECEPTACLE	8	20A			20A	8	BULL PEN RECEPTACLE	6	
7	BULL PEN RECEPTACLE	8	20A			20A	8	BULL PEN RECEPTACLE	8	
9	SCOREBOARD	4	20A			20A	4	SCOREBOARD RECEPTACLE	10	
11	DUGOUT	10	20A			20A	10	DUGOUT	12	
13	FIELD BOX	6	20A			20A	8	SHOT CLOCK	14	
15	SHOT CLOCK	3	20A			20A	8	SHOT CLOCK RECEPTACLE	16	
17	SHOT CLOCK RECEPTACLE	3	20A					BLANK	18	
19	BLANK							BLANK	20	
21	BLANK							BLANK	22	
23	BLANK							BLANK	24	
25	BLANK							BLANK	26	
27	BLANK							BLANK	28	
29	BLANK							BLANK	30	
31	BLANK							BLANK	32	
33	BLANK							BLANK	34	
35	BLANK							BLANK	36	
37	BLANK							BLANK	38	
39	BLANK							BLANK	40	
41	BLANK							BLANK	42	

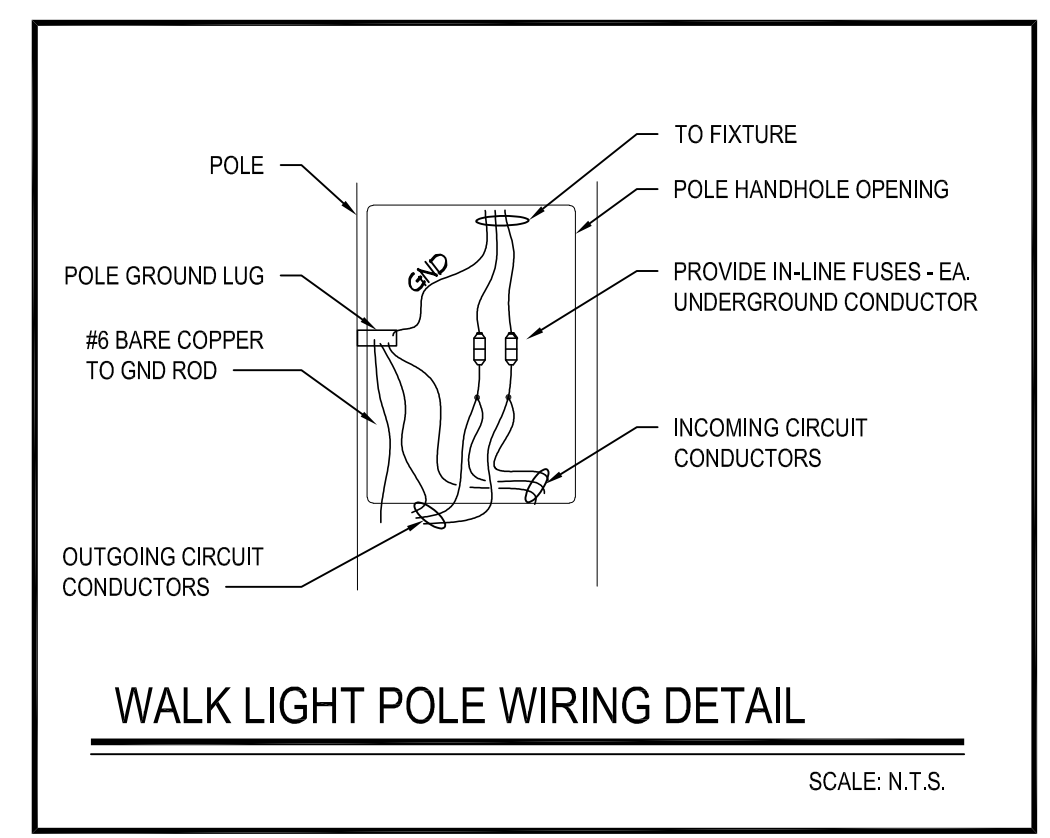

**WALK LIGHT POLE WIRING DETAIL**

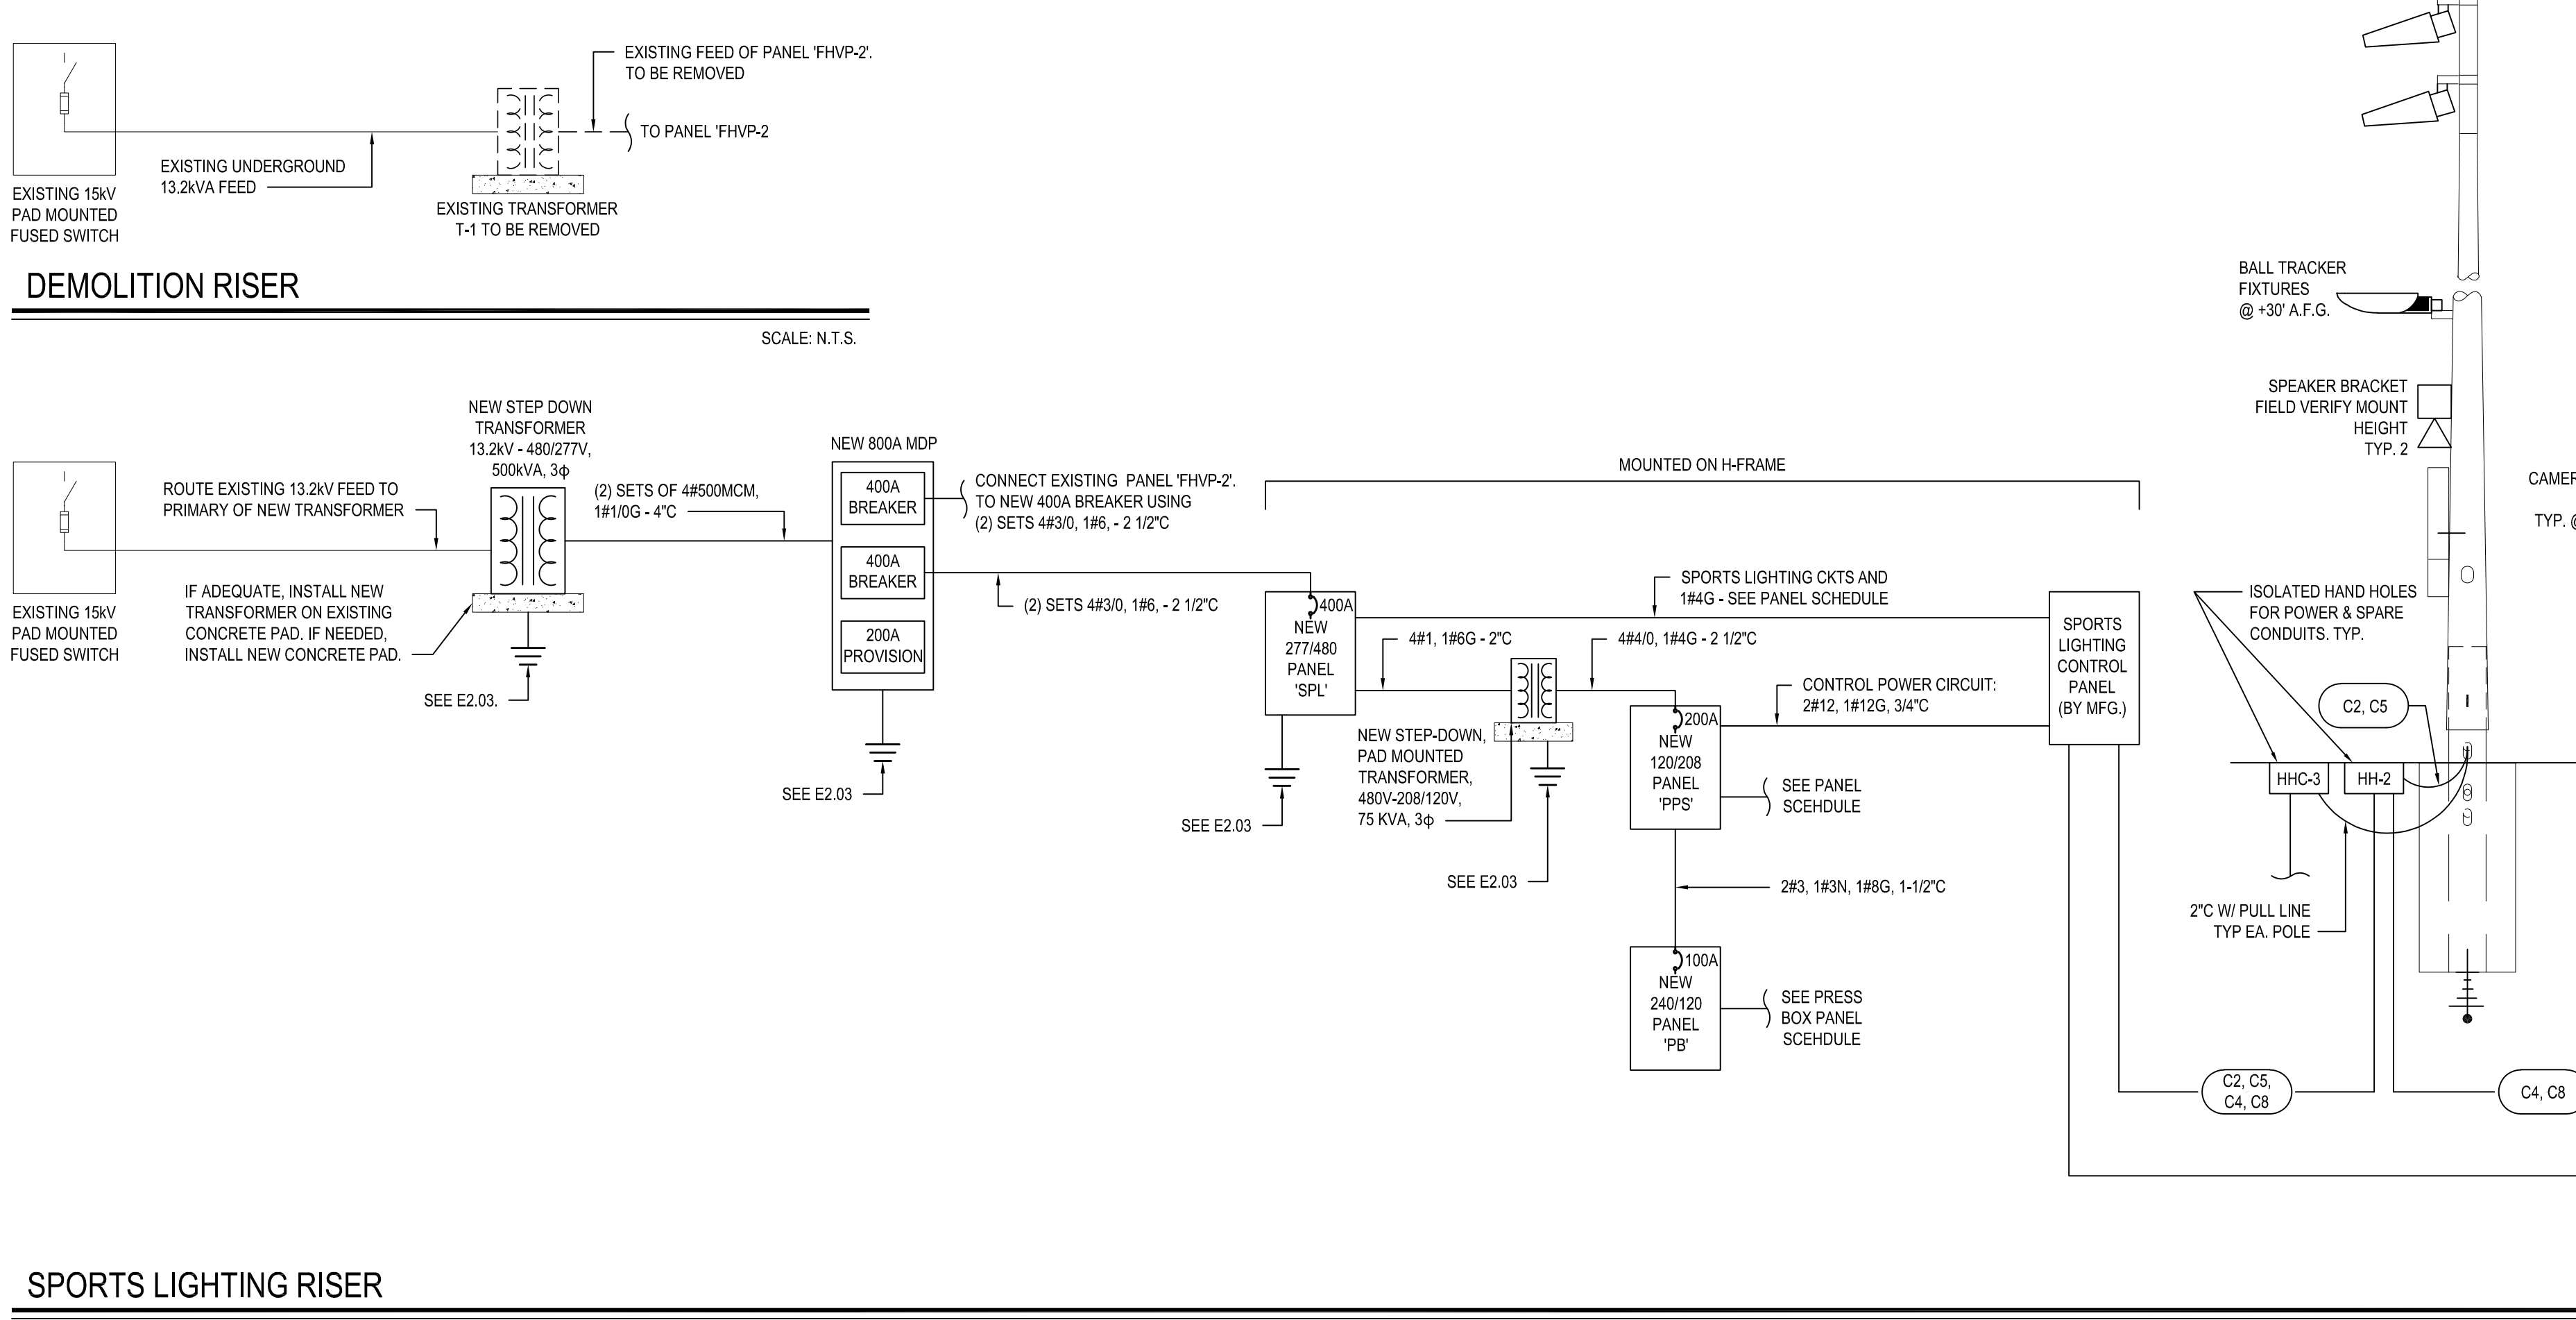

**SPORTS LIGHTING RISER**

SCALE: N.T.S.

REV.	DATE	ITEM

**NOTICE**  
THESE DRAWINGS ARE BASED ON CONSTRUCTION DRAWINGS NOT PREPARED BY BBS ARCHITECTS. LANDSCAPE ARCHITECTS AND ENGINEERS, P.C. AND, THEREFORE, MAY NOT REPRESENT THE CONDITIONS AS CONSTRUCTED AT THE TIME. ALL EXISTING CONDITIONS SHOWN ARE REPRESENTED AS SUGGESTIVE INFORMATION AS THEY HAVE NOT BEEN FIELD AND DETAIL FOR THE ORIGINAL DOCUMENTS OR PER THE OWNER'S INFORMATION.



**KEY PLAN**  
NOT TO SCALE

**MULTI-PURPOSE SYNTHETIC TURF FACILITY PURCHASE COLLEGE STATE UNIVERSITY OF NEW YORK**  
735 ANDERSON HILL ROAD, PURCHASE, NEW YORK 10577


**ELECTRICAL SITE DETAILS**

**PROJECT**  
DRAWING TITLE: DWG TITLE

**DRAWING BY:** RP  
**CHECK BY:** JRL

**NOTICE**  
THE DRAWING PREPARED FOR THE SPECIFIC PROJECT INDICATED IS AN INSTRUMENT OF SERVICE AND THE PROPERTY OF BBS ARCHITECTS, LANDSCAPE ARCHITECTS AND ENGINEERS, P.C. PROJECT IS PROHIBITED. ANY ALTERATION OR REPRODUCTION OF THE DRAWING IS ALSO PROHIBITED WITHOUT THE WRITTEN CONSENT OF THE ARCHITECT OR ENGINEER.

**BBS ARCHITECTS LANDSCAPE ARCHITECTS ENGINEERS**  
244 EAST MAIN STREET, 1ST FLOOR, ALBANY, NEW YORK 12205  
T: 518 621 7650  
F: 518 621 7655  
WWW.BBSARCHITECTURE.COM

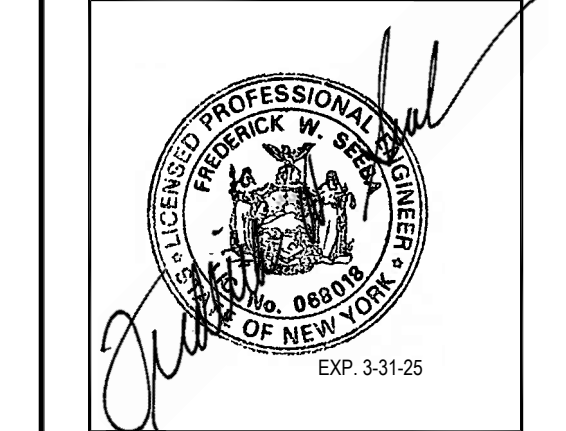

**CONTRACT NO.:** SU-092823 - GENERAL CONST.  
SU-092823 - ELECTRICAL

**CLIENT:** SUNY PURCHASE COLLEGE

**PROJECT:** MULTI-PURPOSE SYNTHETIC TURF FACILITY

**DWG TITLE:** ELECTRICAL SITE DETAILS

**SCALE:** AS NOTED  
**DATE:** OCTOBER 25, 2023  
**BID PICK-UP:**  
**FILE NO.:** 23-158

**E2.02**



**System Requirements: Control System Summary**

Project Name: SUNY Purchase College Softball | Project #: 187766  
Control System ID: 1 of 1  
Distribution Panel Location/ID: Service 1

**Project Information**

**Control System**  
Control System ID: C01  
Control System Type: Control-Link & Control and Monitoring System  
Communication Type: PowerLine-ST

**Project Notes:**

Control cabinets:  
Control voltage (Phase to neutral): 120/60  
VA loading - Inrush: 2533.0  
VA loading - Sealed: 284.0  
Lighting Circuits:  
Voltage/Phase: 480/60/3

**Power Requirements**

Description	Qty	Size (in)
Control and monitoring cabinet - primary	1	24 X 72


- Important Notes:**
- Please confirm that the lighting circuit voltage listed above is accurate for this facility. This is the voltage/phase being connected and utilized at each lighting pole's electrical components enclosure disconnect. Inaccurate voltage/phase can result in additional costs and delays. Contact your Musco sales representative to confirm this item.
  - In a 3 phase design, all 3 phases are to be run to each pole location. Musco's single phase luminaires come pre-wired to utilize all 3 phases across the entire facility.
  - One contactor is required for each circuit at each pole location. Contactors are 3 pole and 100% rated for the published continuous load.
  - If the lighting system will be fed from more than one distribution location, additional equipment may be required. Contact your Musco sales representative.
  - Size overcurrent devices using the full load amps column of the Circuit Summary by Switch chart (Minimum power factor is 0.9). Size conduit per code unless otherwise specified as larger to allow for harness connectors.
  - Avoid use of in-ground junction/pull boxes when possible. If used, all wire connectors must be UL listed for Wet Locations to prevent leakage current.
  - Control power wiring must be in separate conduit from line or load power wiring. Communication cables must be in separate conduit from any power wiring.
  - Refer to Installation Instructions for more details on equipment information and the installation requirements.

Sales Representative: David Kulis JR | Project Engineer: Kelly Martin | Scan: 187766A | Document ID: 187766P1V1-0718082039  
www.musco.com | lighting@musco.com  
Page 1 of 3 - 18 July 2023

**System Requirements: Control System Summary**

Project Name: SUNY Purchase College Softball | Project #: 187766  
Control System ID: 1 of 1  
Distribution Panel Location/ID: Service 1

**Equipment Layout and Connection Details**

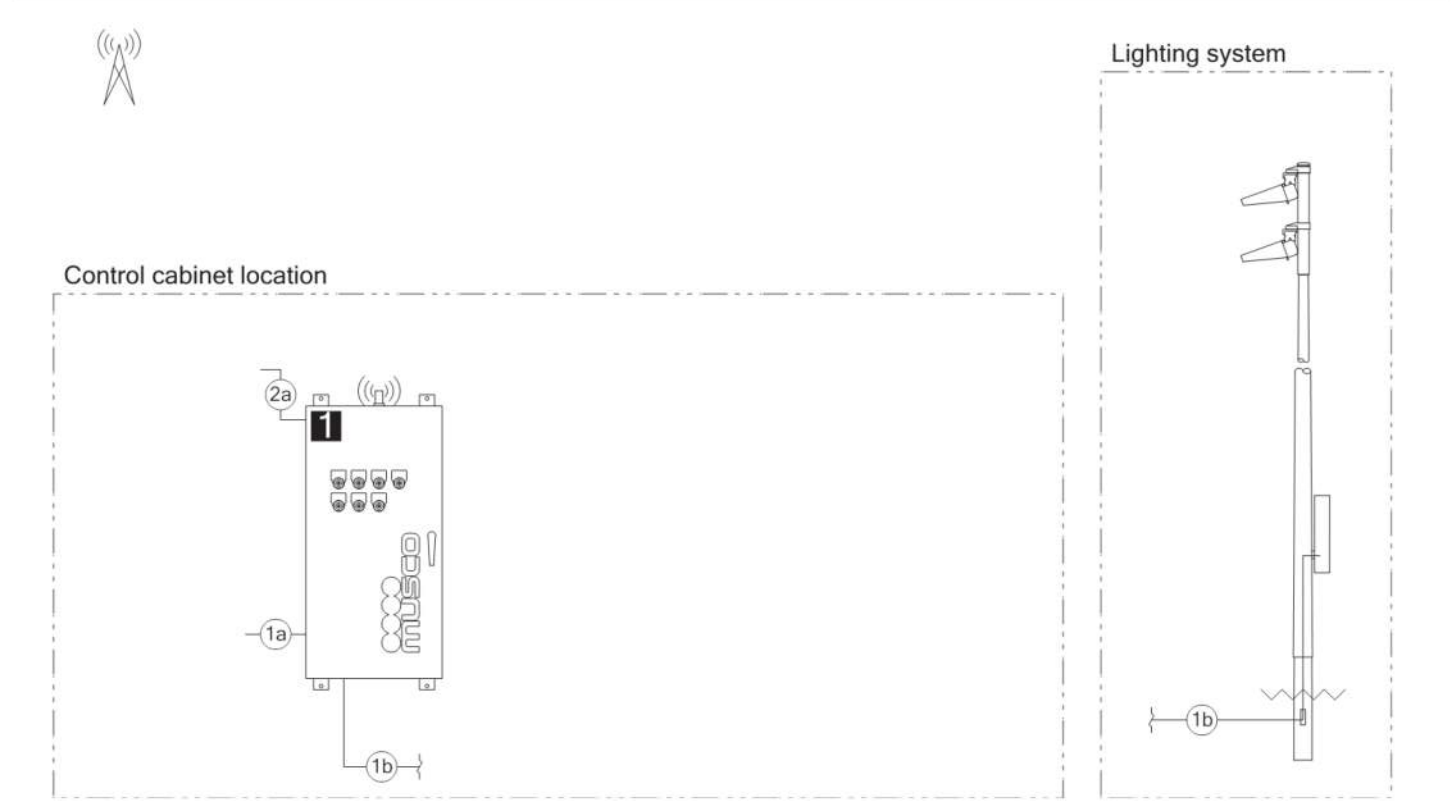

Connection Details		Equipment	
ID	Description	ID	Description
1a	Line power to contactors, and equipment grounding conductor. Requires one circuit per contactor, size wiring per load and voltage drop.	1	Control and monitoring cabinet - primary
1b	Load power from contactors, and equipment grounding conductor. Requires one circuit per contactor, size wiring per load and voltage drop.		
2a	Control power with equipment ground to control cabinet. Requires dedicated 20 A circuit. Provide transformer if control voltage not present.		

Sales Representative: David Kulis JR | Project Engineer: Kelly Martin | Scan: 187766A | Document ID: 187766P1V1-0718082039  
www.musco.com | lighting@musco.com  
Page 2 of 3 - 18 July 2023

**System Requirements: Control System Summary**

Project Name: SUNY Purchase College Softball | Project #: 187766  
Control System ID: 1 of 1  
Distribution Panel Location/ID: Service 1

**Circuit Summary**

Field/Switch Description	Switches
Softball	1
Multipurpose	2

**Control Module ID: 1** Lighting Circuit Voltage: 480/60/3

Switch	Zone Description	Pole ID	Qty of Fixtures	Full load amperes	Contactor Size (Amps)	Cabinet #	Contactor ID
1	Softball	A1	6	8.41	30	1	C1
	Softball	A2	6	8.41	30	1	C2
	Softball	B1	10	19.57	30	1	C3
	Softball	B2	10	19.57	30	1	C4
2	Multipurpose	A2	11	25.15	30	1	C5
	Multipurpose	S1	7	15.72	30	1	C6
	Multipurpose	S2	7	15.72	30	1	C7
	Multipurpose	S3	12	25.15	30	1	C8

**Single Luminaire Amperage Draw Chart**


Driver (30 min power factor)	Max Line Amperage Per Luminaire					
Single Phase Voltage	200 (80)	228 (90)	248 (98)	277 (108)	347 (135)	380 (148)
TLC-LED-1200	6.9	6.5	6.0	5.2	4.2	3.8
TLC-LED-1500	8.4	7.9	7.3	6.3	5.0	4.6
TLC-LED-900	5.2	4.9	4.5	3.9	3.1	2.9
TLC-BT-575	3.4	3.2	2.9	2.5	2.0	1.8

**Light Level Summary**




Grid Name	Calculation Metric	Area	Min	Max	Avg	Circuits	Fixture Qty
Bulbpen LF	Horizontal	50.6	42	63	1.47	A	32
Bulbpen RF	Horizontal	46.3	37	57	1.55	A	32
Field (Multipurpose)	Horizontal Illuminance	46.4	21	61	2.89	B	37
Multipurpose	Horizontal Illuminance	50.3	40	58	1.47	B	37
Softball Bleachers	Horizontal	27.5	9	41	5.16	A	32
Softball (Infield)	Horizontal Illuminance	74	62	84	1.36	A	32
Softball (Outfield)	Horizontal Illuminance	53.6	35	78	2.22	A	32
Spill 150' (CG)	Max Candela (by Fixture)	4548	513	9830	19.15	A,B	69
Spill 150'	Horizontal Illuminance	0.09	0.01	0.35	65.34	A,B	69
Spill 150'	Max Vertical Illuminance Metric	0.23	0.02	0.79	39.48	A,B	69
Youth Field	Horizontal Illuminance	41.6	30	58	1.59	B	37

Sales Representative: David Kulis JR | Project Engineer: Kelly Martin | Scan: 187766A | Document ID: 187766P1V1-0718082039  
www.musco.com | lighting@musco.com  
Page 3 of 3 - 18 July 2023

**EQUIPMENT GROUNDING DETAIL - NEW TRANSFORMER**

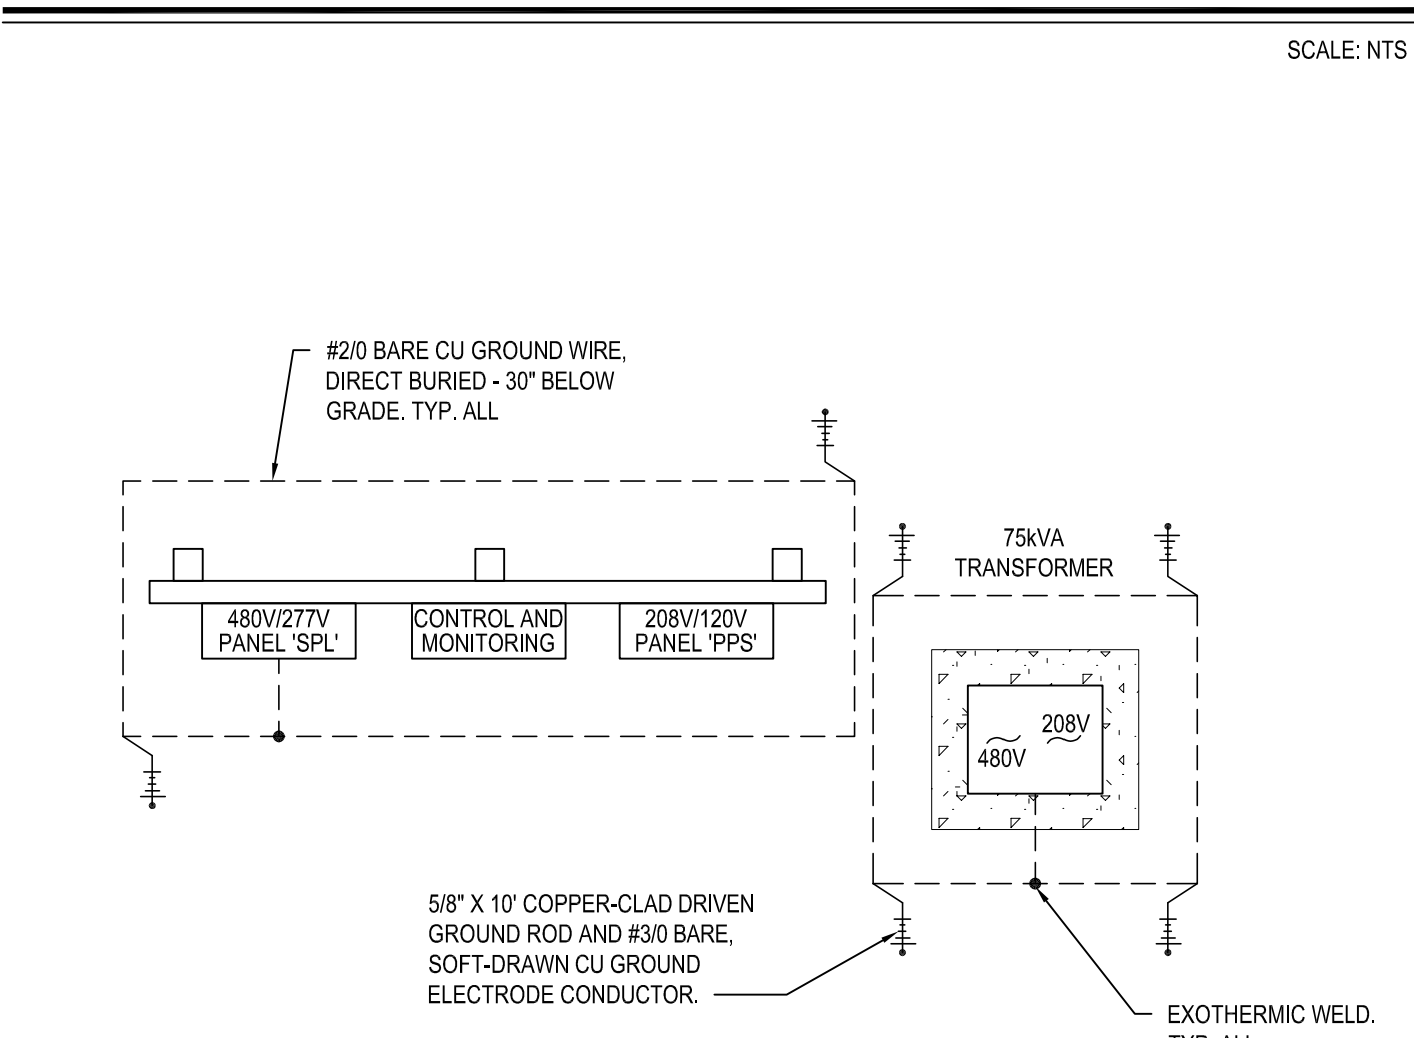

**EQUIPMENT GROUNDING DETAIL - SITE LIGHTING & POWER**

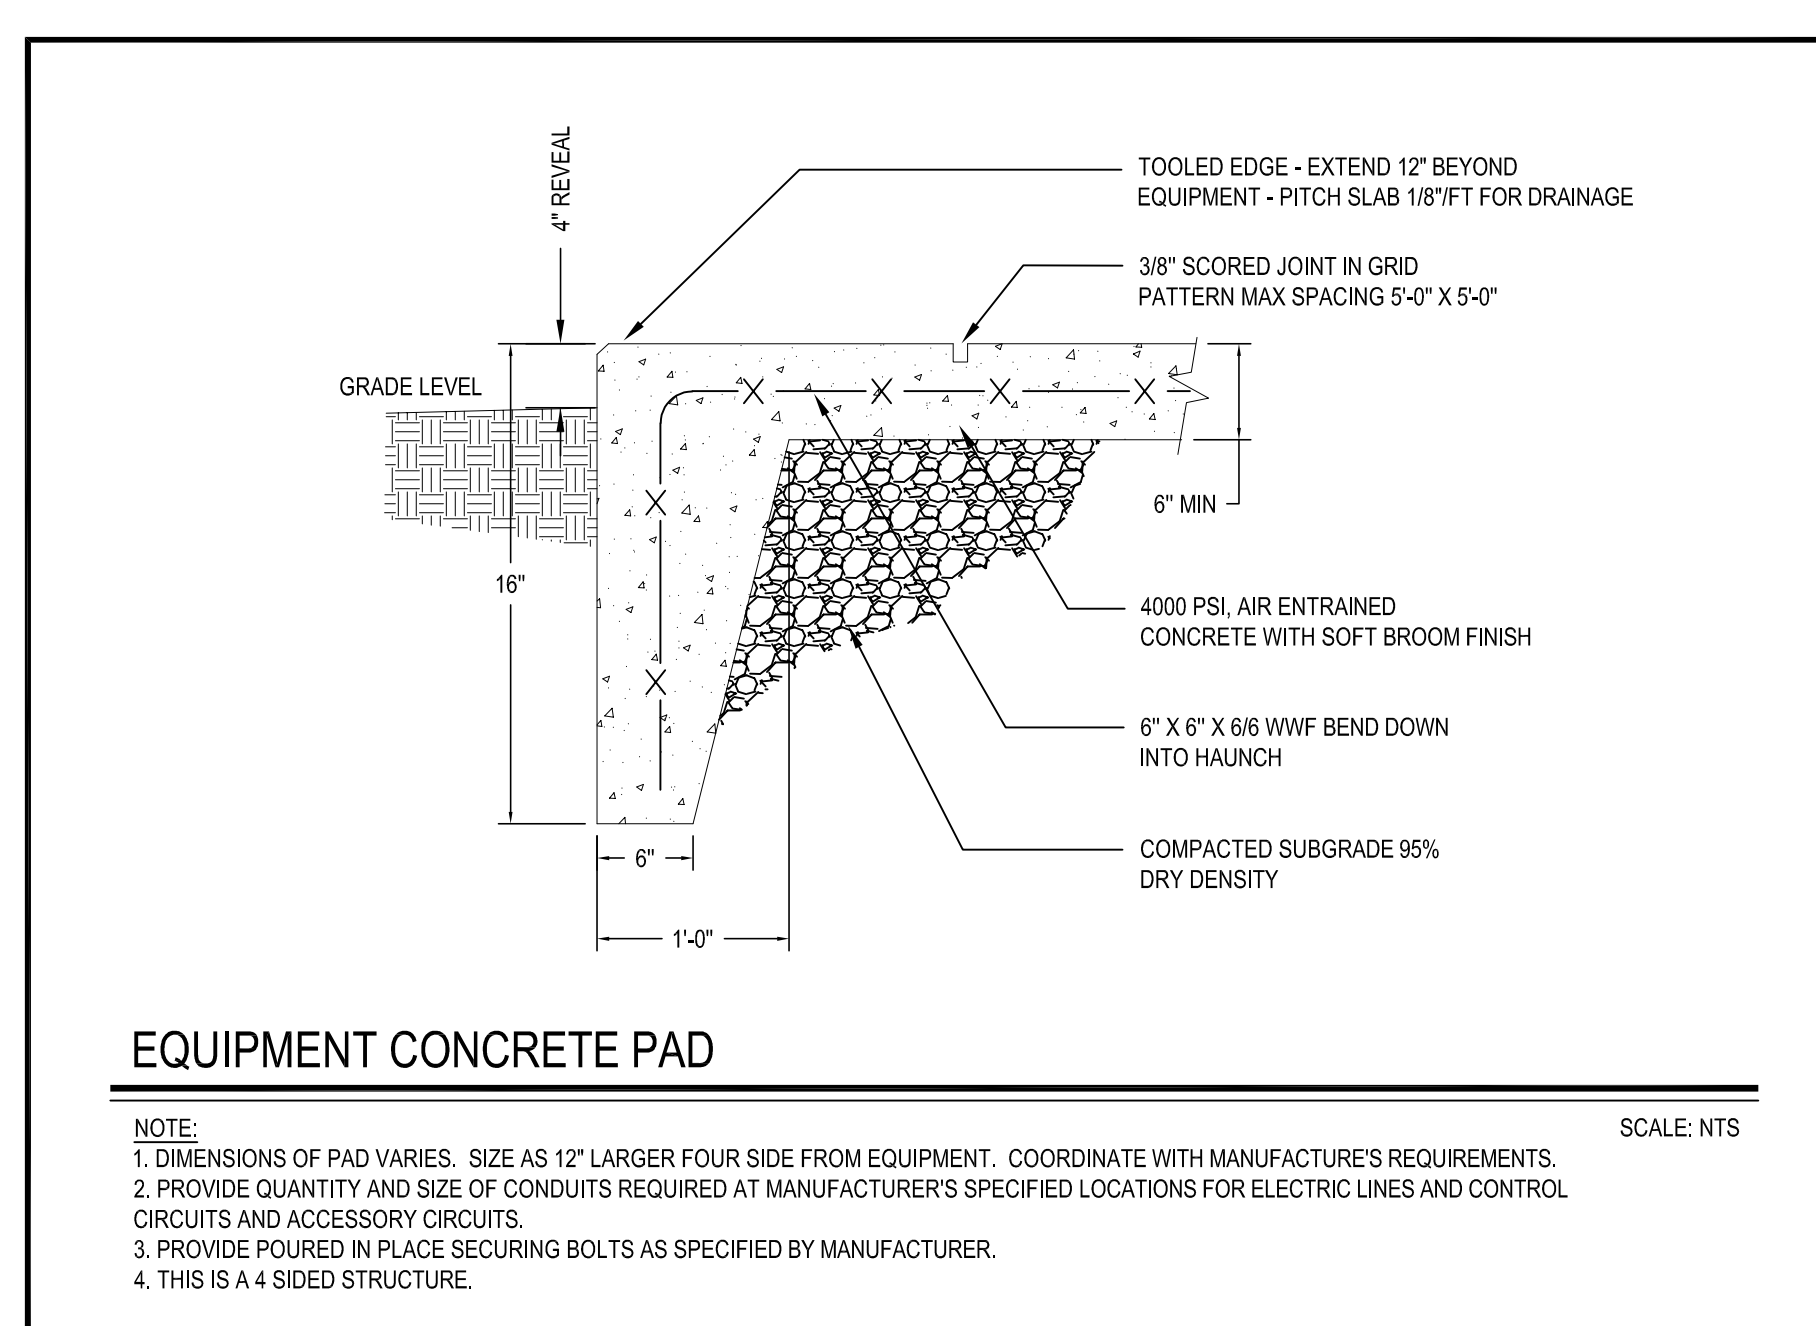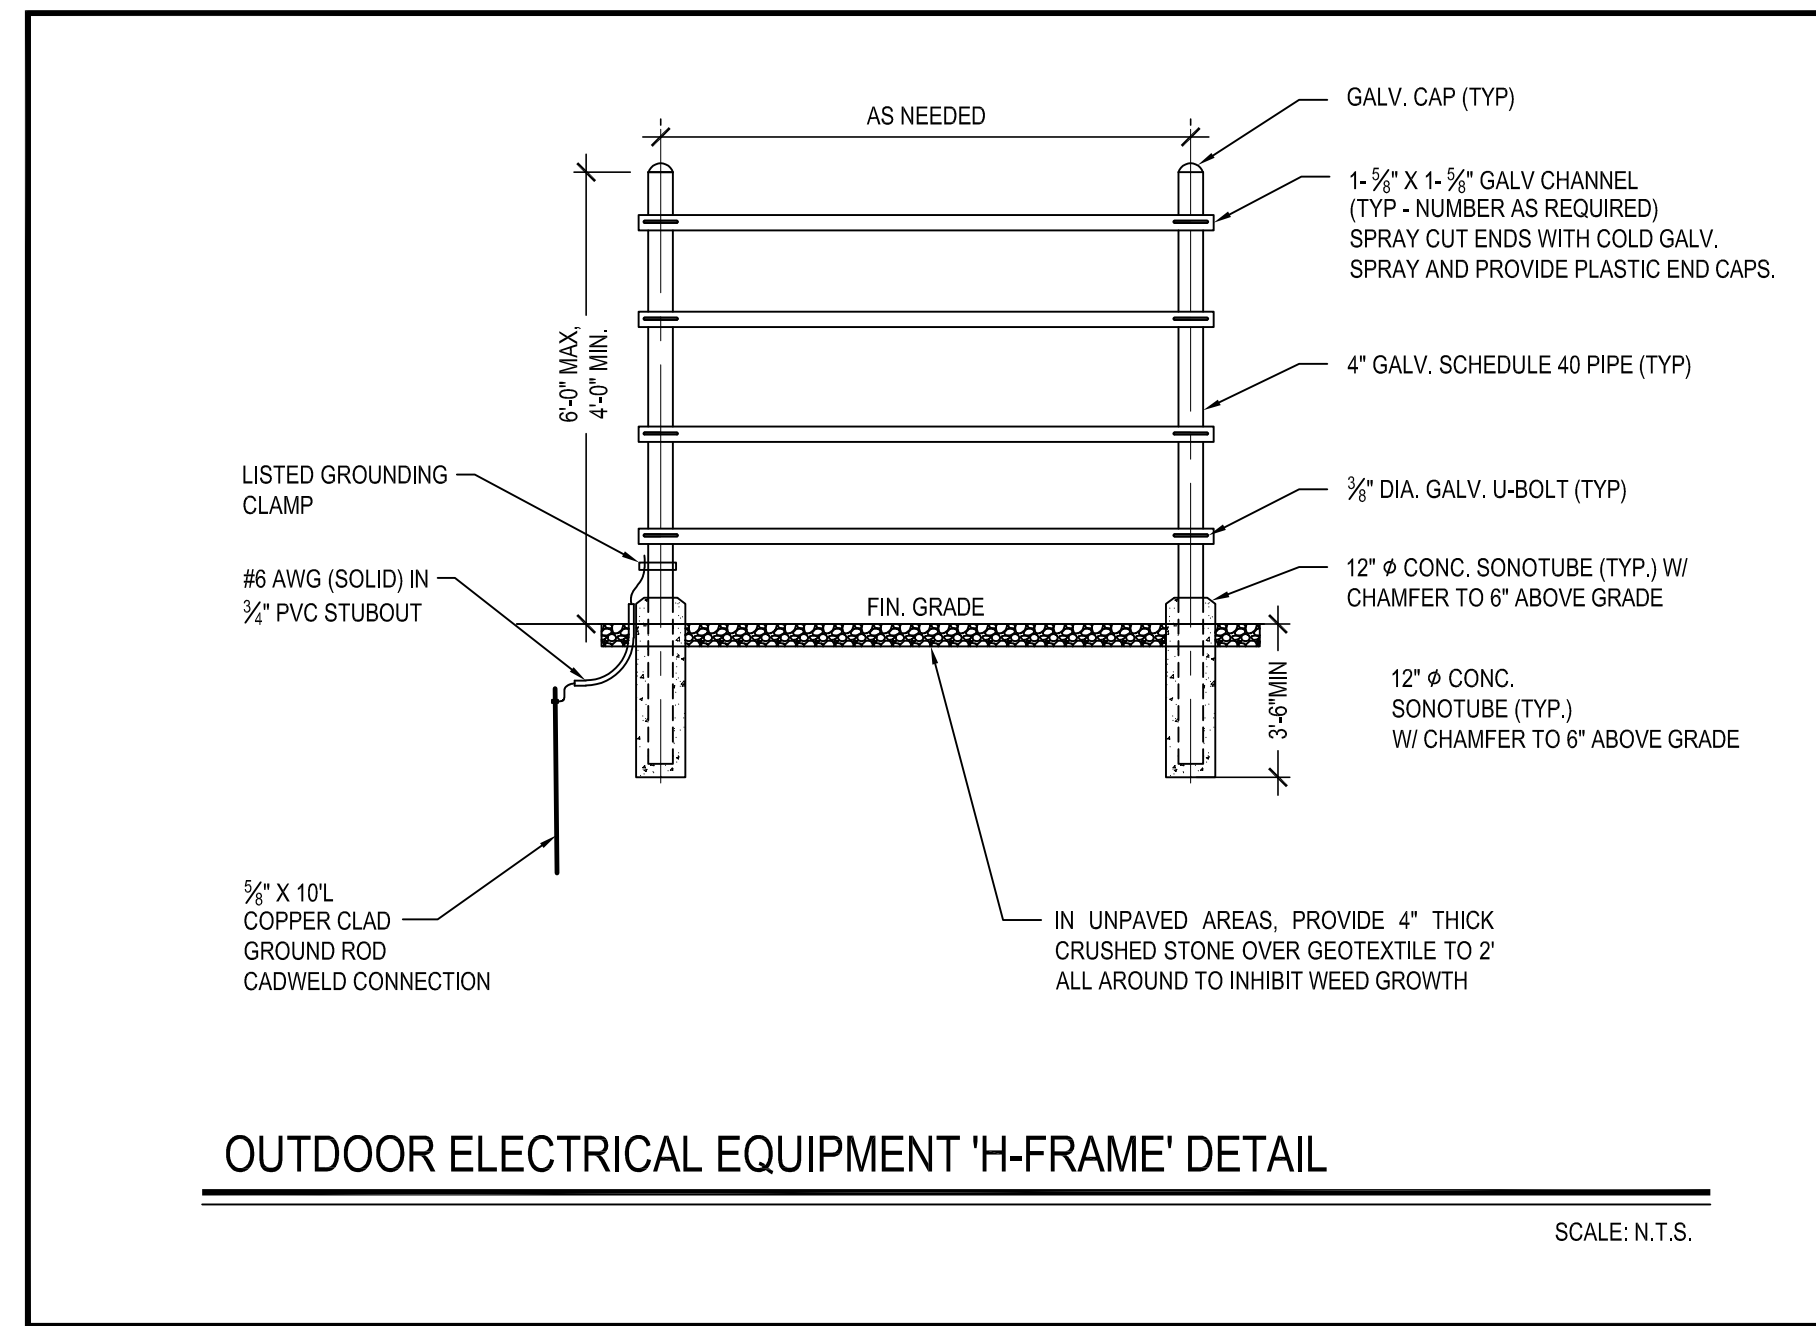 

**POLE FOUNDATION SCHEDULE**

POLE DESIGNATION	FORCES (F <sub>1</sub> )			DRILLED PIER		
	MOMENT (M) FT-LBS	SHEAR (V) LBS	VERTICAL (P) LBS	DIAMETER INCHES	EMBEDMENT DEPTH	SUSPENSION ** (Z)
A1	41,911	1,134	1,410	36	12'-0"	NA
A2	245,610	3,891	6,006	36	20'-0"	NA
B1, B2	119,651	2,339	3,419	36	16'-0"	NA
S1	112,801	2,173	3,262	36	18'-0"	2'-0"
S2	112,801	2,173	3,262	36	16'-0"	NA
S3	243,474	3,715	6,364	36	20'-0"	NA

**DESIGN NOTES**

- ADD LOAD COMBINATION D + 0.6V. VERTICAL FORCE IS WEIGHT OF DRESSED POLE (DOES NOT INCLUDE PRECAST BASE WEIGHT).
- SUSPEND PRECAST BASE \*\* OFF THE BOTTOM OF THE EXCAVATION DURING MONOLITHIC CONCRETE BACKFILL PLACEMENT AND CURING. NA = NOT APPLICABLE. SUSPENSION NOT REQUIRED.
- MINIMUM CONCRETE BACKFILL VOLUME, SITE CONDITIONS MAY REQUIRE ADDITIONAL BACKFILL.

**PRECAST BASE IDENTIFICATION**

PRECAST BASE TYPE	PRECAST BASE WEIGHT	PRECAST BASE LENGTH	PROJECTION ABOVE GRADE	STANDARD EMBEDMENT	OUTSIDE DIAMETER
3B	2,470 LBS	20'-0"	6'-0"	12'-0"	13'-38"
5B	4,580 LBS	23'-11"	7'-11"	16'-0"	18'-29"
7B	10,160 LBS	27'-10"	7'-10"	20'-0"	23'-7"

**POLE IDENTIFICATION**

POLE DESIGNATION	POLE TYPE	PRECAST BASE TYPE	FIXTURE CONFIGURATION (FIX. PER ARM)	FIXTURE AND ACCESSORIES EPA (F <sub>2</sub> )
A1	L880B	3B	6 (4)	13.7
A2	L8810C	7B	17 (6+)	46.3
B1, B2	L880B	5B	10 (7)	27.4
S1, S2	L880B	5B	7 (7)	20.3
S3	L8810C	7B	12 (6+)	37.2

**POLE FOUNDATION ELEV.**

**SUNY PURCHASE COLLEGE SOFTBALL FIELD LIGHTING PURCHASE, NY**

**DESIGN PARAMETERS:**  
WIND: 120 MPH, Max 93 MPH (EXPOSURE C, RISK CATEGORY II) PER 2020 BUILDING CODE OF NEW YORK STATE (ASCE 7-16).  
DESIGN WIND PARAMETERS ARE AS NOTED. ACTUAL EXPOSURE MUST BE VERIFIED FOR THE SITE BY THE PROPER GOVERNING OFFICIAL.

**GEOTECHNICAL PARAMETERS:**  
ALLOWABLE END BEARING SOIL PRESSURE: 3000 PSF  
ALLOWABLE LATERAL SOIL BEARING PRESSURE:  
0 PER FT (GRADE TO 3'-0"); VARIES. SEE SOIL BORING LOGS (BELOW 3'-0") IN ACCORDANCE WITH THE 2020 BUILDING CODE OF NEW YORK STATE, CHAPTER 16.

**DESIGN SOIL PARAMETERS ARE AS NOTED. ACTUAL ALLOWABLE SOIL PARAMETERS MUST BE VERIFIED ON SITE. REFERENCE SUBSURFACE INVESTIGATION REPORT & BORING LOGS, JOB NO. 23-235, BY SOIL MECHANICS INVESTIGATION REPORT & SEAFORD, NY.**

A GEOTECHNICAL ENGINEER OR REPRESENTATIVE OF IT IS RECOMMENDED NOT REQUIRED TO BE AVAILABLE AT THE TIME OF THE FOUNDATION INSTALLATION TO VERIFY THE SOIL DESIGN PARAMETERS AND TO PROVIDE ASSISTANCE IF ANY PROBLEMS ARISE IN FOUNDATION INSTALLATION.

ENCOUNTERING SOIL FORMATIONS THAT WILL REQUIRE SPECIAL DESIGN CONSIDERATIONS OR EXCAVATION PROCEDURES MAY OCCUR. POLE FOUNDATIONS WILL NEED TO BE ANALYZED ACCORDING TO THE SOIL CONDITIONS THAT EXIST. IF ANY DISCREPANCIES OR INCONSISTENCIES ARISE, NOTIFY THE ENGINEER OF SUCH DISCREPANCIES. FOUNDATIONS WILL THEN BE REVISED ACCORDINGLY. REVISIONS WILL BE ANALYZED PER RECOMMENDATIONS DIRECTED BY A REGISTERED ENGINEER.

ALL EXCAVATIONS MUST BE FREE OF LOOSE SOIL AND DEBRIS PRIOR TO FOUNDATION INSTALLATION AND CONCRETE BACKFILL PLACEMENT. TEMPORARY CASINGS OR DRILLERS SLURRY MAY BE USED TO STABILIZE THE EXCAVATION DURING INSTALLATION. CASINGS MUST BE REMOVED DURING CONCRETE BACKFILL PLACEMENT. CONCRETE BACKFILL MUST BE PLACED WITH A TRIMME WHEN SLURRY OR WATER IS PRESENT WITHIN THE EXCAVATION.

CONCRETE SHALL BE AIR-ENTRAINED AND HAVE A MINIMUM COMPRESSIVE DESIGN STRENGTH AT 28 DAYS OF 3,000 PSI. 3,000 PSI CONCRETE SPECIFIED FOR EARLY POLE ERECTION. ACTUAL REQUIRED MINIMUM ALLOWABLE CONCRETE STRENGTH IS 1,000 PSI. ALL PIERS AND CONCRETE BACKFILL MUST BEAR ON AND AGAINST FIRM UNDISTURBED SOIL.

**GENERAL NOTES:**  
FIXTURES MUST BE LOCATED TO MAINTAIN 10'-0" MINIMUM HORIZONTAL CLEARANCE FROM ANY OBSTRUCTION. ENGINEER MUST BE NOTIFIED IF FOUNDATIONS ARE NEAR ANY RETAINING WALLS OR WITHIN / NEAR ANY SLOPES STEEPER THAN 3H : 1V. POLES, FIXTURES, PRECAST BASES, ELECTRICAL ITEMS AND INSTALLATION PER MUSCO LIGHTING.

**CONTRACTOR MUST BE FAMILIAR WITH THE COMPLETE SOIL INVESTIGATION REPORT AND BORINGS, AND CONTACT THE GEOTECHNICAL FIRM IF NECESSARY TO UNDERSTAND THE SOIL CONDITIONS AND THE POSSIBILITY OF GROUND WATER PUMPING AND EXCAVATION STABILIZATION OR BRACING DURING PRECAST BASE INSTALLATION AND PLACEMENT OF CONCRETE BACKFILL.**

**CONCRETE:**  
CONCRETE SHALL BE AIR-ENTRAINED AND HAVE A MINIMUM COMPRESSIVE DESIGN STRENGTH AT 28 DAYS OF 3,000 PSI. 3,000 PSI CONCRETE SPECIFIED FOR EARLY POLE ERECTION. ACTUAL REQUIRED MINIMUM ALLOWABLE CONCRETE STRENGTH IS 1,000 PSI. ALL PIERS AND CONCRETE BACKFILL MUST BEAR ON AND AGAINST FIRM UNDISTURBED SOIL.

**GENERAL NOTES:**  
FIXTURES MUST BE LOCATED TO MAINTAIN 10'-0" MINIMUM HORIZONTAL CLEARANCE FROM ANY OBSTRUCTION. ENGINEER MUST BE NOTIFIED IF FOUNDATIONS ARE NEAR ANY RETAINING WALLS OR WITHIN / NEAR ANY SLOPES STEEPER THAN 3H : 1V. POLES, FIXTURES, PRECAST BASES, ELECTRICAL ITEMS AND INSTALLATION PER MUSCO LIGHTING.

REV.	DATE	ITEM

**NOTICE**  
THESE DRAWINGS ARE BASED ON CONSTRUCTION DRAWINGS NOT PROVIDED BY THE ARCHITECTS. LANDSCAPE ARCHITECTS AND ENGINEERS, P.C. AND THEREFORE MAY NOT REPRESENT THE CONDITIONS AS CONSTRUCTED AT THE TIME. ALL EXISTING CONDITIONS SHOWN ARE REPRESENTED AS SUGGESTIVE INFORMATION AS THEY MAY NOT HAVE BEEN BUILT AND RETAINED PER THE ORIGINAL DOCUMENTS OR PER THE OWNER'S INFORMATION.

**KEY PLAN**  
NOT TO SCALE

**PROJECT**  
MULTI-PURPOSE SYNTHETIC TURF FACILITY  
PURCHASE COLLEGE  
STATE UNIVERSITY OF NEW YORK  
735 ANDERSON HILL ROAD, PURCHASE, NEW YORK 10577

**DWG TITLE**  
ELECTRICAL SITE DETAILS

**DRAWING BY:** RP  
**CHECK BY:** JRL

**NOTICE**  
THIS DRAWING PREPARED FOR THE SPECIFIC PROJECT INDICATED BY THE ARCHITECTURE OF SERVICE AND THE PROPERTY OF THE ARCHITECTS, LANDSCAPE ARCHITECTS AND ENGINEERS, P.C. NO REPRODUCTION OR ANY USE OF THIS DRAWING FOR ANY OTHER PROJECT IS PROHIBITED WITHOUT THE WRITTEN CONSENT OF THE ARCHITECT OR ENGINEER.

**BBS ARCHITECTS LANDSCAPE ARCHITECTS ENGINEERS**  
244 EAST MAIN STREET ALBANY, NEW YORK 12205  
1.631.475.0549 F.518.621.7650  
F.518.621.0561  
www.BBSARCHITECTURE.com

**CONTRACT NO.:** SU-02823 - GENERAL CONST.  
**SU-02923 - ELECTRICAL**

**CLIENT:** SUNY PURCHASE COLLEGE

**PROJECT:** MULTI-PURPOSE SYNTHETIC TURF FACILITY

**DWG TITLE:** ELECTRICAL SITE DETAILS

**SCALE:** AS NOTED  
**DATE:** OCTOBER 25, 2023  
**BID PICK-UP:**  
**FILE NO.:** 23-158

**E2.03**